


T.17S. R.4W. W.M.

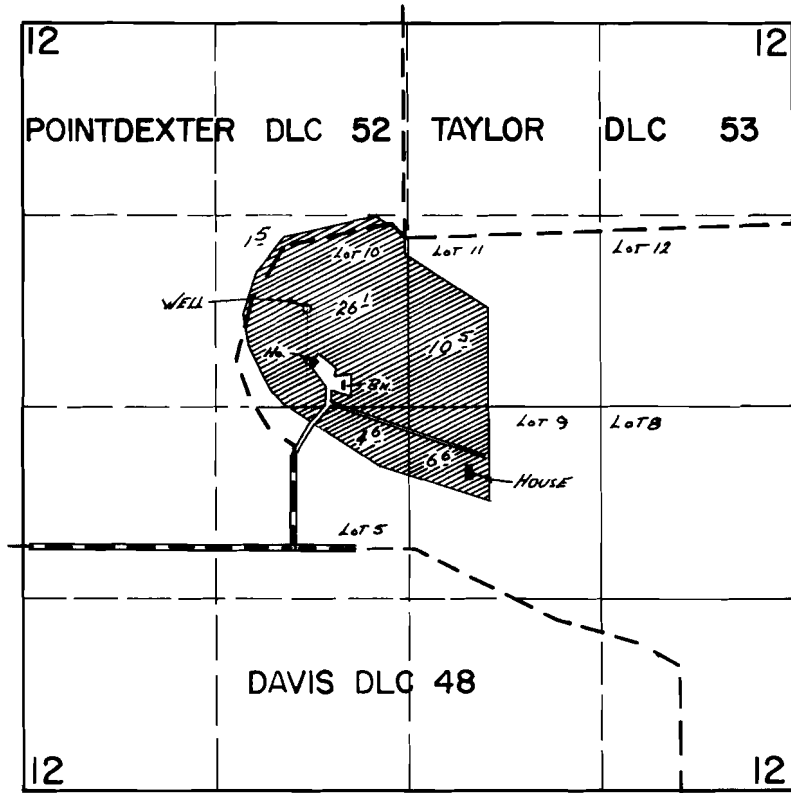

WELL LOC 1650' N 1° 10' E FROM SE COR POINTDEXTER DLC 52

FINAL PROOF SURVEY
UNDER

Application No. G-5316 Permit No. G-5141
IN NAME OF

MRS. CARRIE G. BABB

Surveyed May 6 1974, by T. J. PAUL