


T.16S. R.3E. W. M.

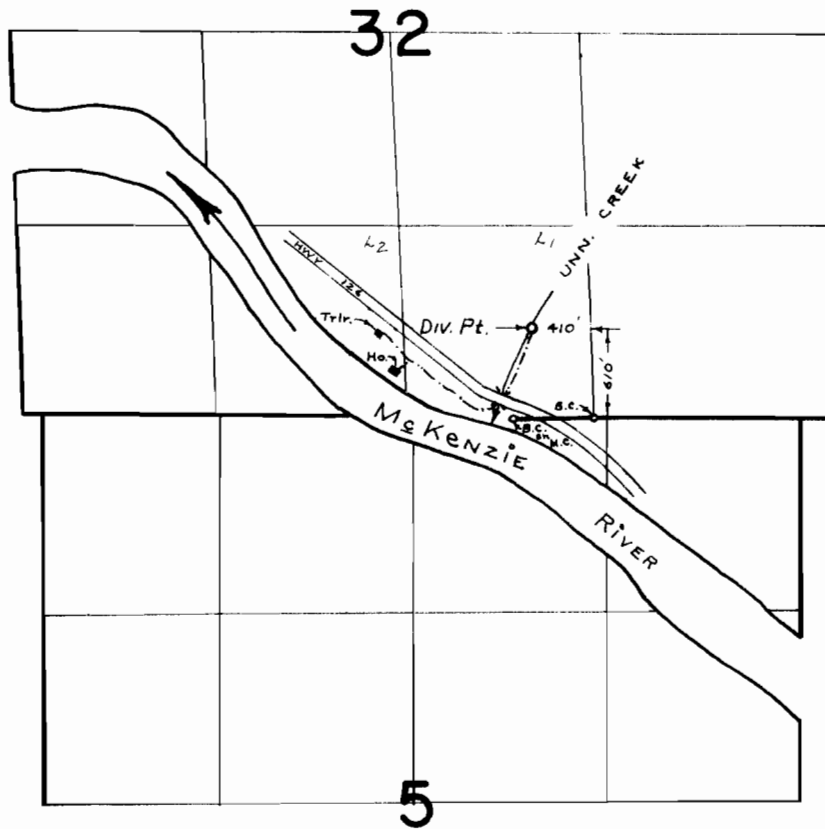

FINAL PROOF SURVEY
UNDER

Application No. 38928 Permit No. 28970
IN NAME OF
MARVIN McCLURE,
& HERBERT F. GRAHAM

Surveyed April 25, 1975, by R. MUCKEN