


T.17S. R.6W. W.M.

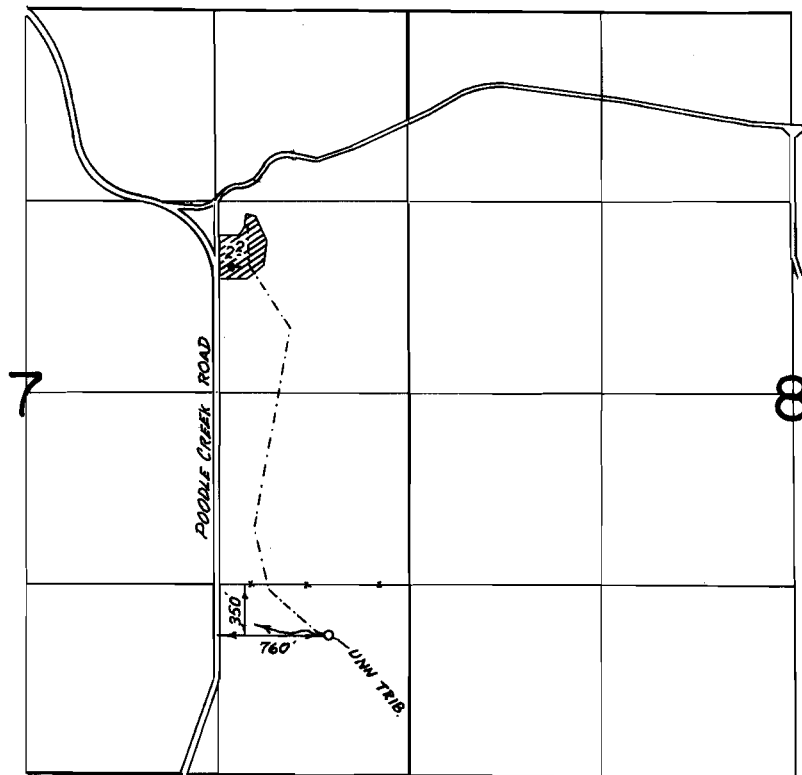

FINAL PROOF SURVEY
UNDER

Application No. 40704 Permit No. 30321
IN NAME OF

CECIL GATEWOOD

Surveyed May 10 1974, by T. J. PAUL