


T.20S. R.3W. W.M.

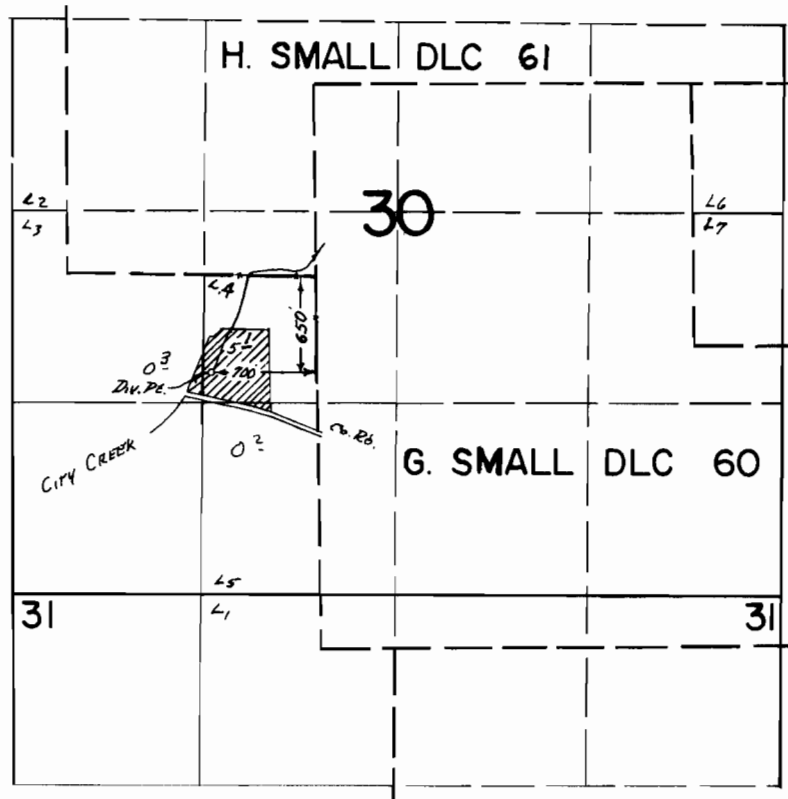

FINAL PROOF SURVEY
UNDER

Application No. 42009 Permit No. 31439
IN NAME OF

VIRGIL M. FULLBRIGHT

Surveyed Aug. 14, 1974, by D. M. NORBY.