


T.17 S. R.6W. W.M.

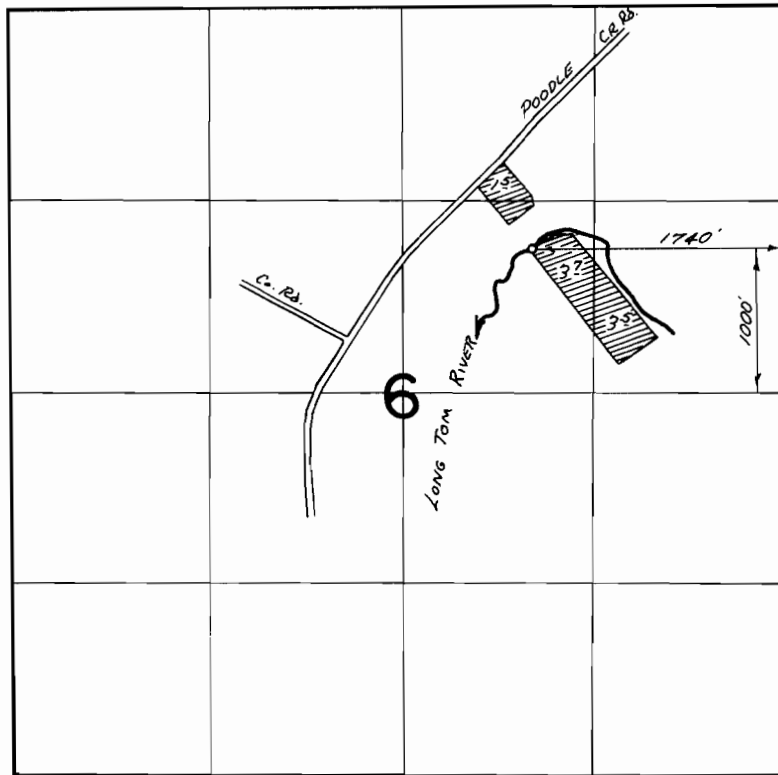

FINAL PROOF SURVEY
UNDER

Application No. 42176..... Permit No. 31600.....
IN NAME OF

..... JOHN L. CHAPMAN

Surveyed May 10 1974, by T. J. PAUL.....