


T.17S. R.6W. W.M.

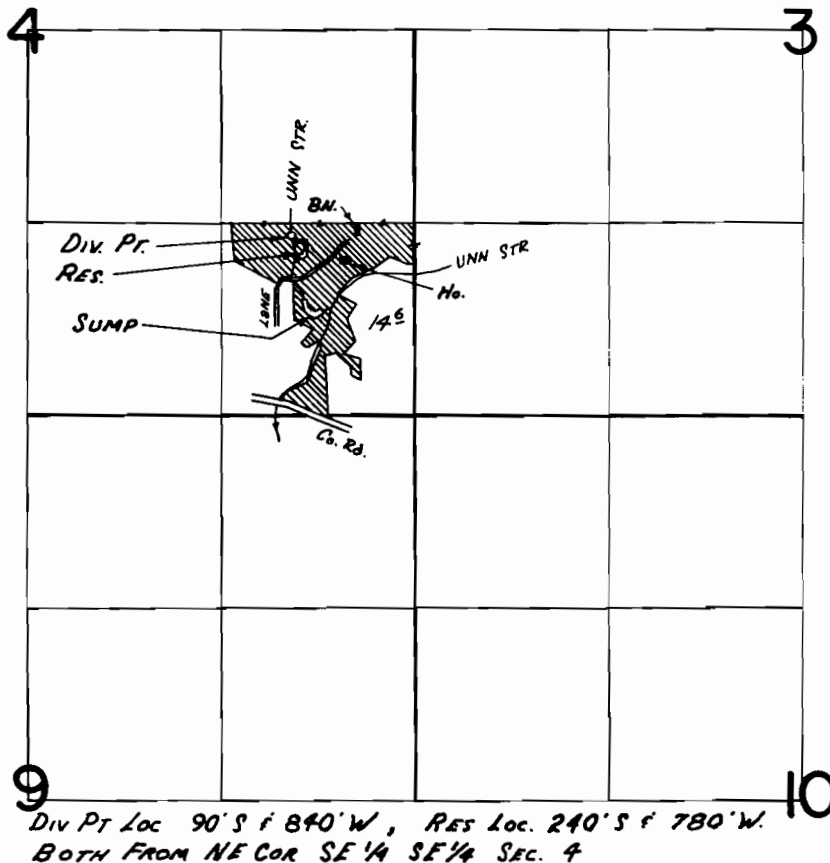

FINAL PROOF SURVEY
UNDER

R-44209 R-5030
Application No. 43534 Permit No. 32675
IN NAME OF

DONALD L. STIMSON

Surveyed May 8, 1974, by T. J. PAUL