


T.17S. R.6W. W.M.

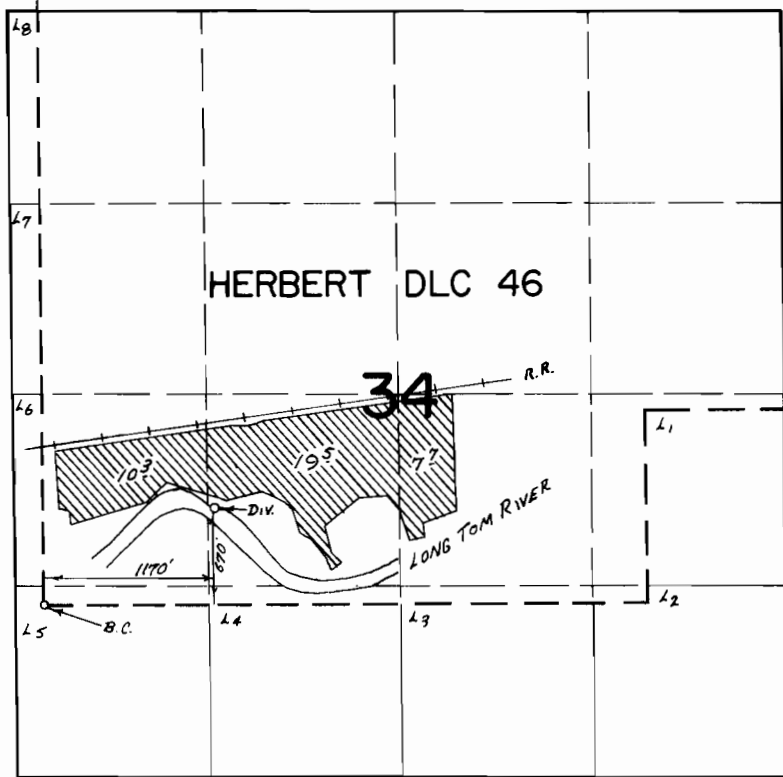

**FINAL PROOF SURVEY**  
UNDER

Application No. 44712 ... Permit No. 32981 ...  
IN NAME OF

STANLEY R. THOMAS

Surveyed May 10, 1974, by T. J. PAUL