


T.17S. R.12W. W. M.

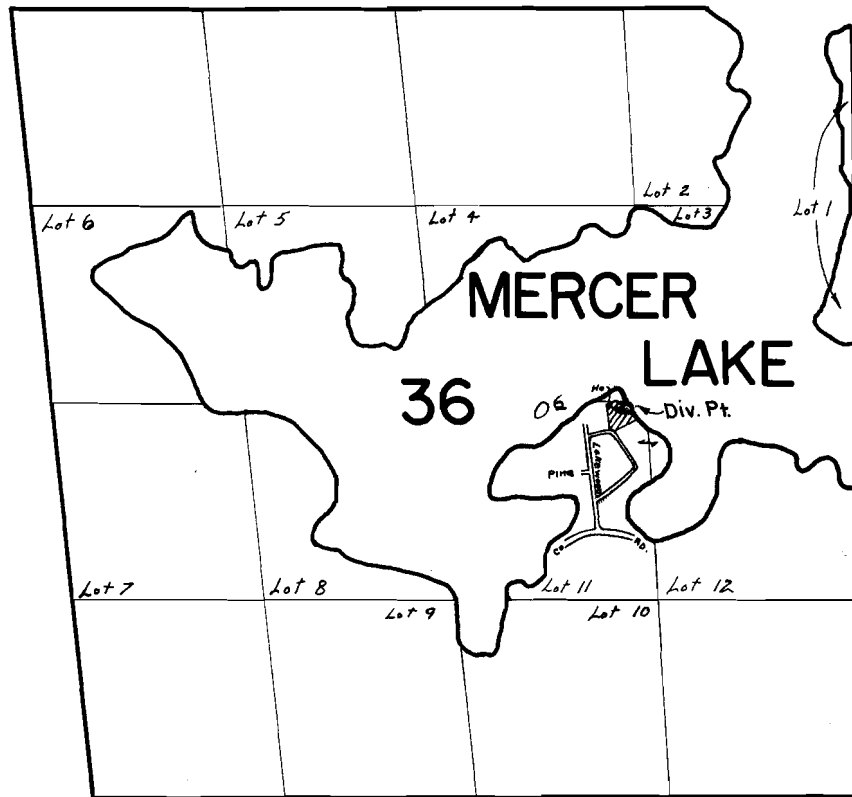

Div. Pt. Loc: 2670' N. $\frac{1}{2}$ 1580' W. from S.E. cor. Sec. 36

FINAL PROOF SURVEY
UNDER

Application No. 44622 Permit No. 33125
IN NAME OF

ERNEST A. PICKETT

Surveyed JULY 10, 1974, by L.E. GOULD