


T.19S.R.1W.W.M.

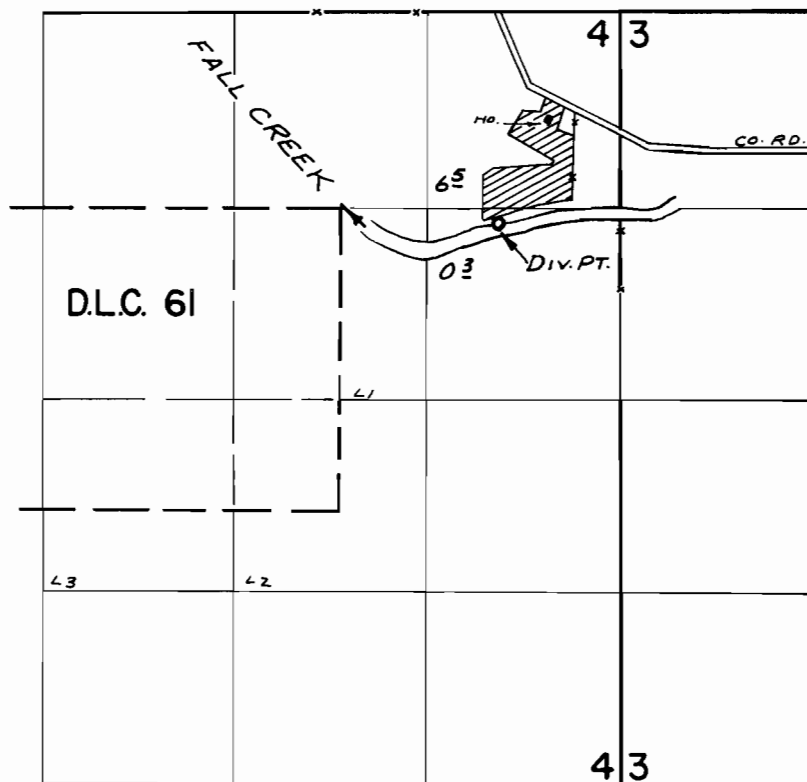

DIV. PT. LOC: 1470'S. & 830'W. FROM NE. COR. SEC. 4

FINAL PROOF SURVEY
UNDER

Application No. 44961... Permit No. 33604...
IN NAME OF

JOHN CALKINS

Surveyed MAY 9, 1974, by R. MUCKEN