


T.18S.R.2W.W.M.

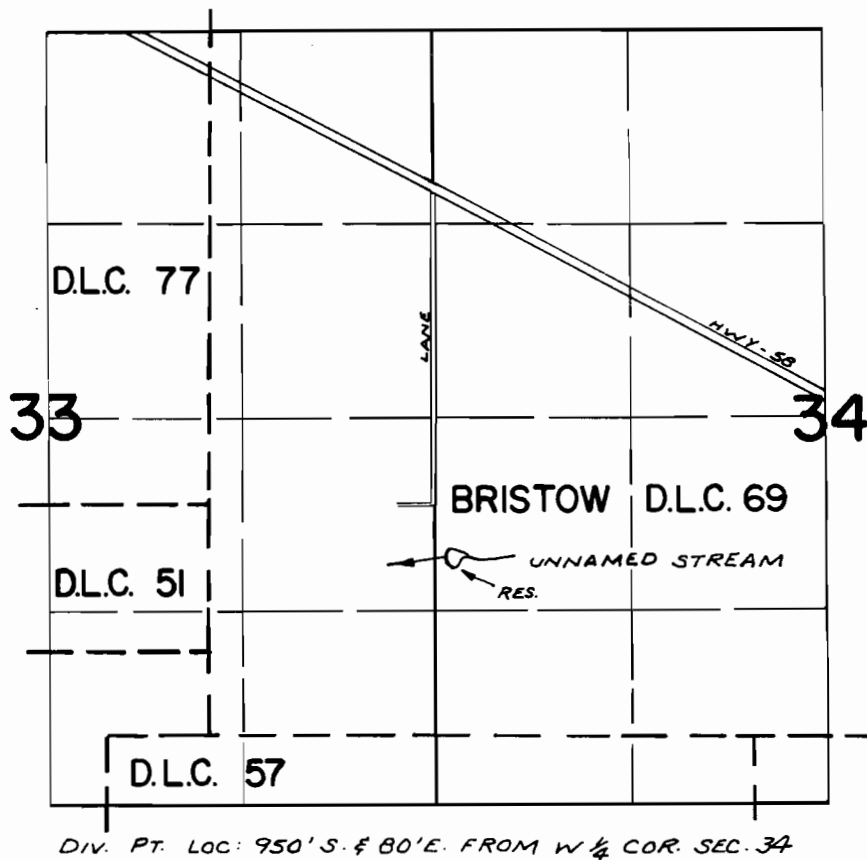

FINAL PROOF SURVEY
UNDER

R-45499 R-5380
Application No. ~~45688~~ Permit No. 33997.....
IN NAME OF

ALLEN J. THOMASHEFSKY.....

Surveyed MAY 6, 1974, by R. MUCKEN