


T.18S.R.2W.W.M.

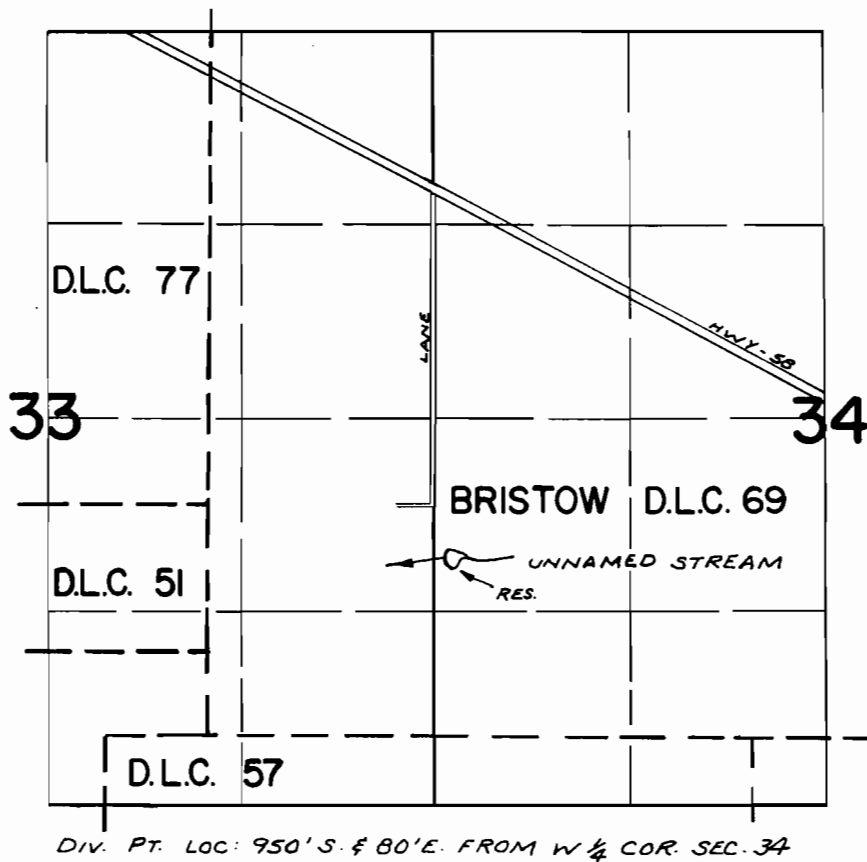

FINAL PROOF SURVEY
UNDER

Application No. R-45499 45688 Permit No. R-5380 33997.....
IN NAME OF

ALLEN J. THOMASHEFSKY

Surveyed MAY 6, 1974, by R. MUGGEN