


T.19S.R.1W.W.M.

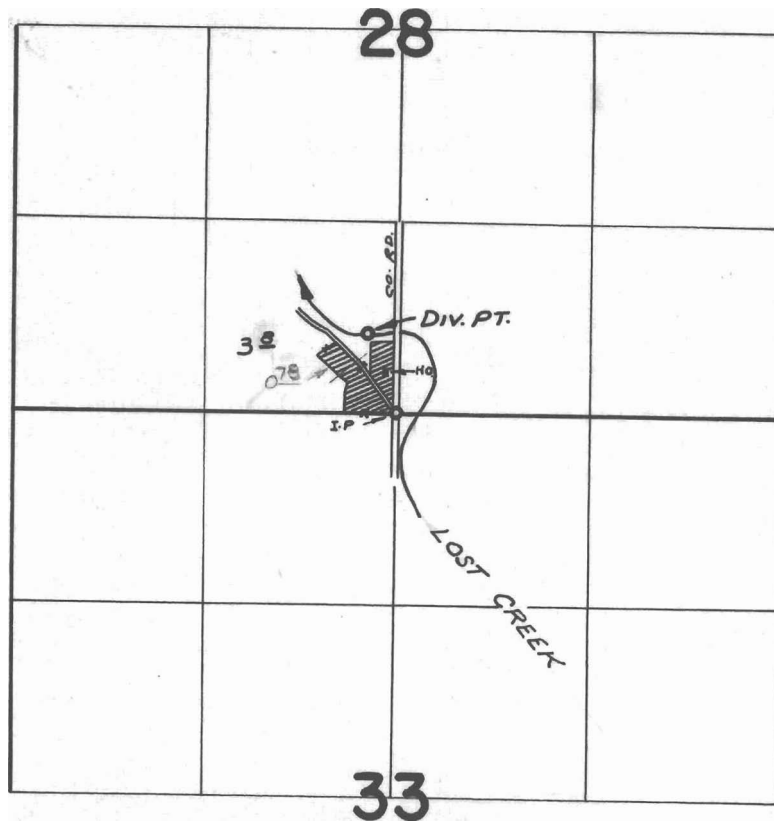

DIV. PT. LOC: 550' N. & 200' W. FROM S $\frac{1}{4}$ COR. SEC. 28

FINAL PROOF SURVEY
UNDER

Application No. 46210.... Permit No. 34526....
IN NAME OF

...ESTATE OF VERN L. HUCKA.....

Surveyed MAY 9, 1974, by R. MUCKEN.