


T.16S. R.5E. W.M.

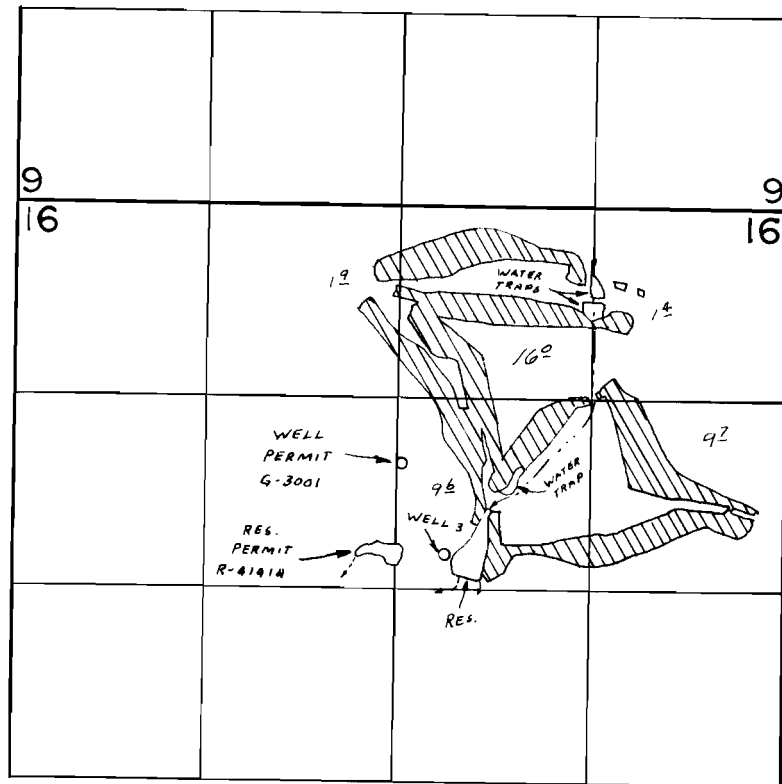

DAM LOC. 100' N. & 440' E ; WELL LOC. 240' N. & 330' E
BOTH FROM CENTER SEC. 16

FINAL PROOF SURVEY
UNDER

R-46383

R-5521

46384

34643

Application No. G-4980 Permit No. G-4699

IN NAME OF

N. B. GIUSTINA

Surveyed AUG 21 1974, by L.H. NUNN