


# T.19S.R.1E.W.M.

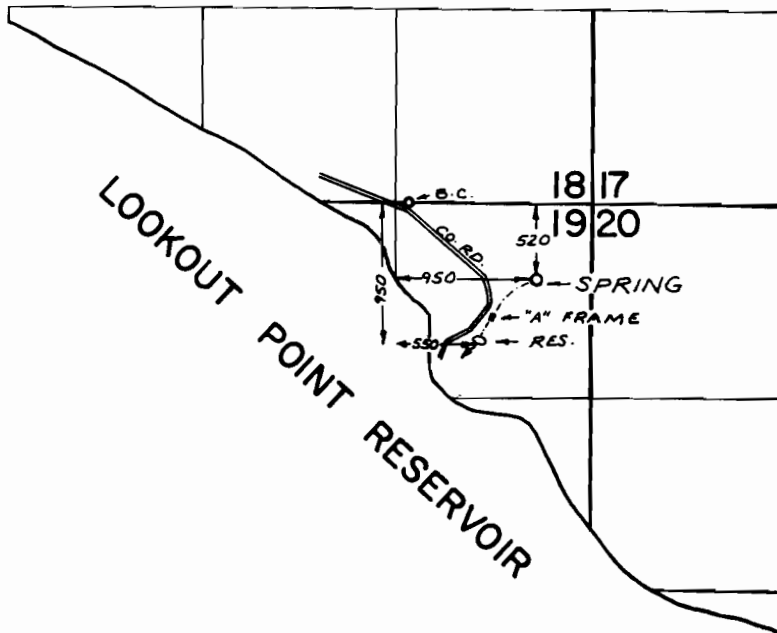

## FINAL PROOF SURVEY UNDER

Application No. R-46446 ~~46447~~ Permit No. R-5558 ~~34800~~  
IN NAME OF

DYROL JAY BURLESON

Surveyed MAY 2 1974, by R. MUGGEN