


# T.19S.R.1E.W.M.

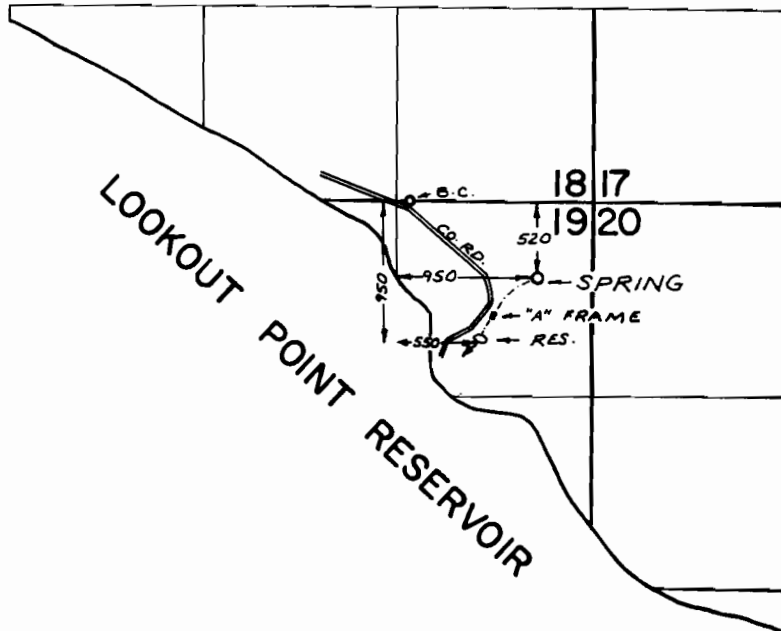

## FINAL PROOF SURVEY UNDER

Application No. R-46446 46447 Permit No. R-5558 34800  
IN NAME OF

DYROL JAY BURLISON

Surveyed MAY 2 1974, by B. MUGGEN