


T.17S. R.9W. W.M.

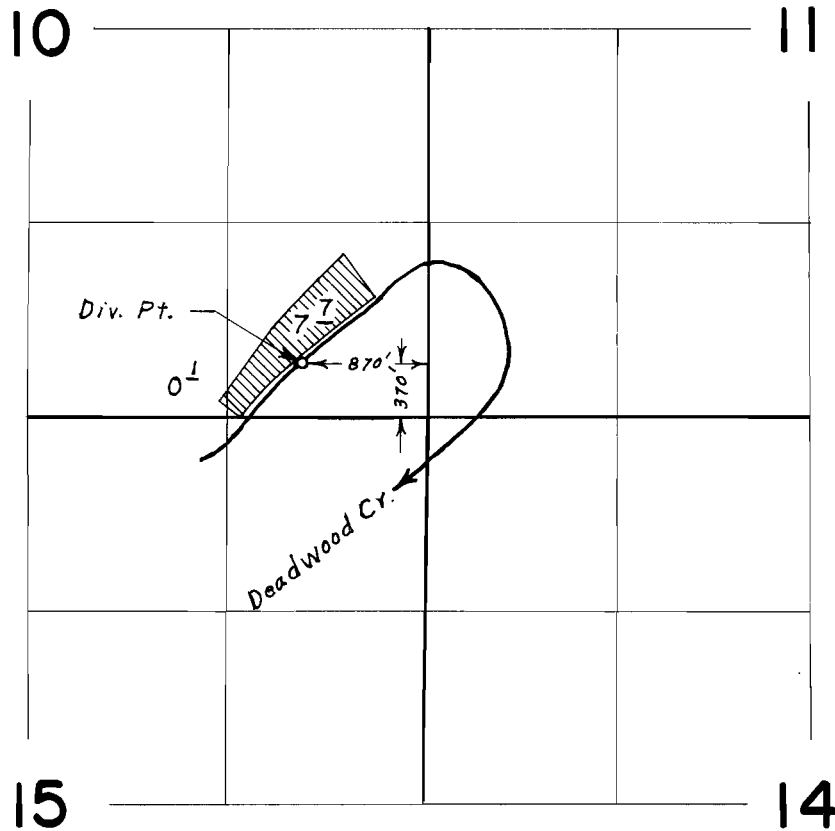

FINAL PROOF SURVEY
UNDER

Application No. 46864 Permit No. 35040
IN NAME OF

HAROLD JONES

Surveyed July 11, 1974, by L. E. Gould