


T.20S. R.3W. W.M.

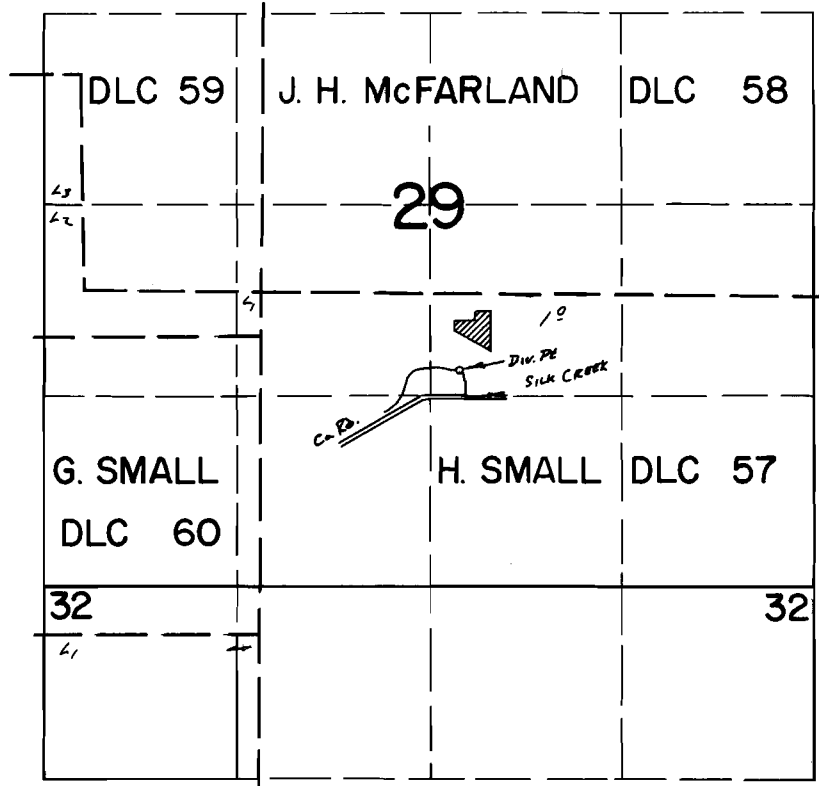

Div. PE. LOC 1490' N + 200' E FROM S 1/4 COR. SEC. 29

FINAL PROOF SURVEY
UNDER

Application No. 48261... Permit No. 35501...
IN NAME OF

WALLACE G. & PAULINE R. ROBERTSON

Surveyed Aug. 12, 1974, by D. M. NORBY...