


T.18S.R.1W.W.M.

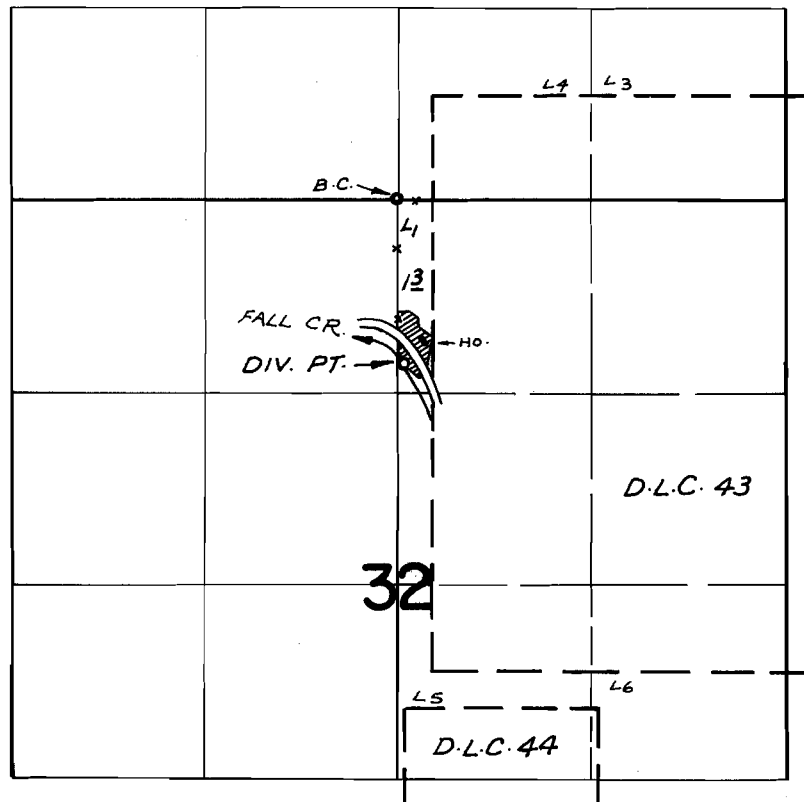

DIV. PT. LOC: 1120'S. & 40'E. FROM N $\frac{1}{4}$ COR. SEC. 32

FINAL PROOF SURVEY
UNDER

Application No. 48451 Permit No. 35516
IN NAME OF

CLIFFORD LONG

Surveyed MAY 10, 1974, by R. MUCKEN