


T.15 S. R.5 W. W.M.

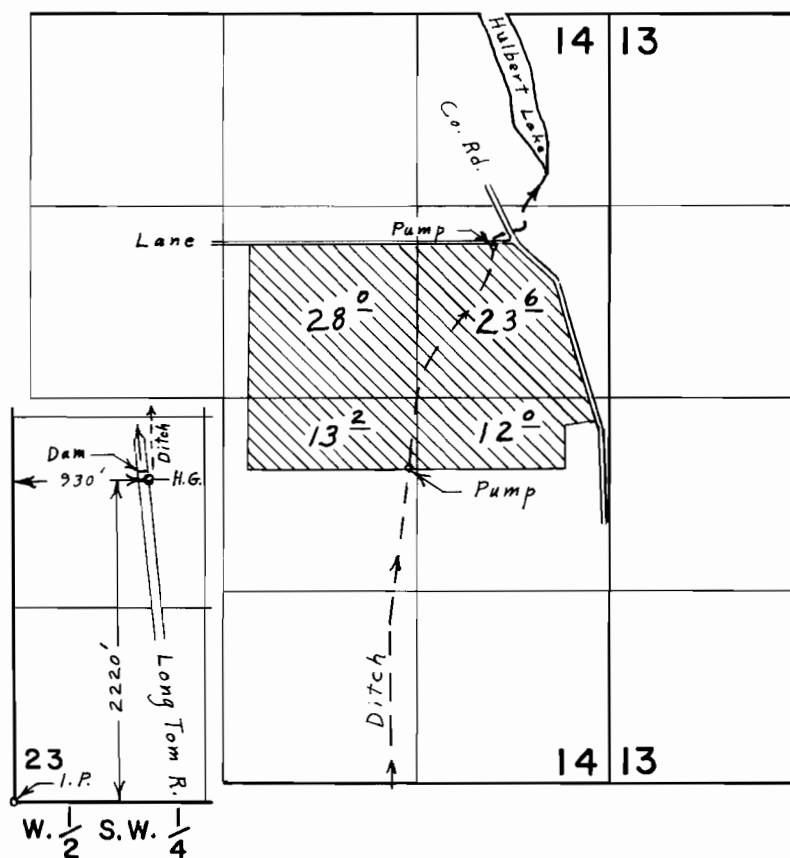

FINAL PROOF SURVEY
UNDER

Application No. 49028 Permit No. 35704
IN NAME OF
JAMES T. & BESSIE D. NIELSEN

Surveyed Sept. 24, 1974, by L. TOLL