


T.17S. R.6W. W.M.

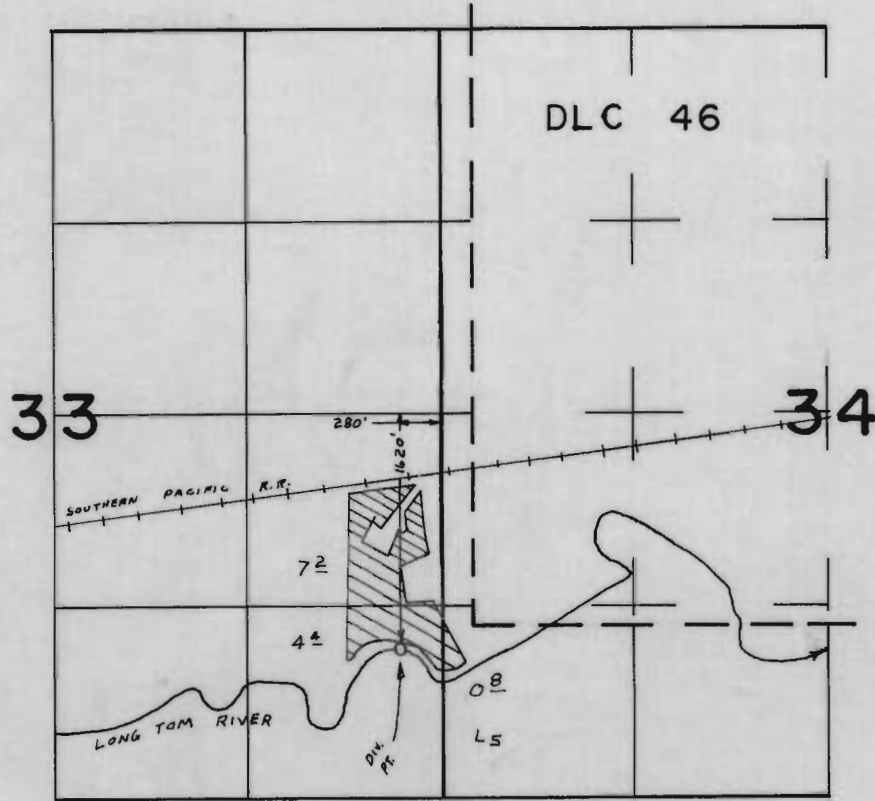

FINAL PROOF SURVEY
UNDER

Application No. 47796 Permit No. 35808
IN NAME OF

ALBERT O. RUSTAD

Surveyed OCT. 30 1974, by LH NUNN