


T.16S. R.2E. W.M.

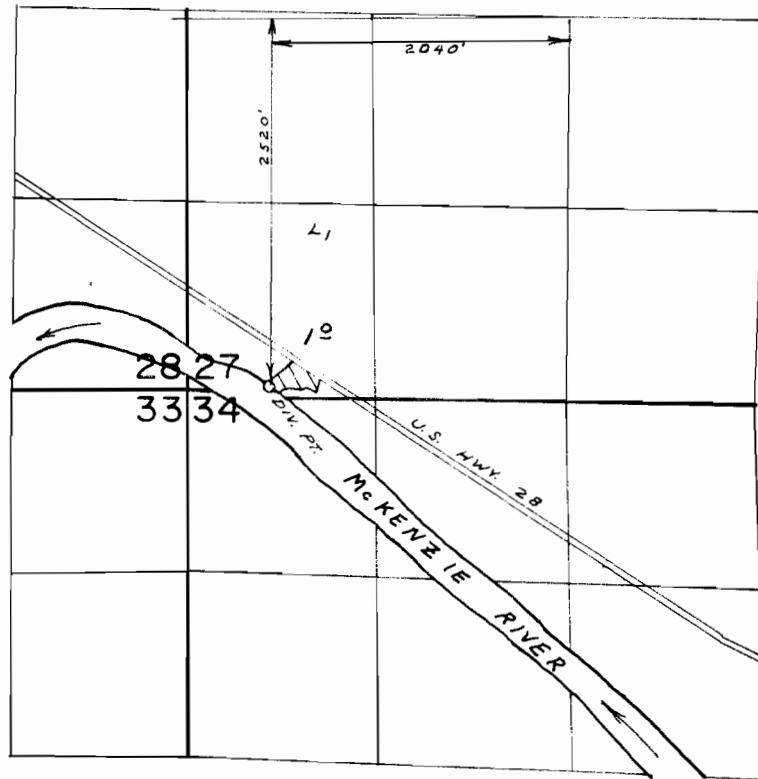

FINAL PROOF SURVEY
UNDER

Application No. 48643 Permit No. 36086
IN NAME OF

W. EATON WATSON

Surveyed AUG. 22 1974, by L.H. NUNN