


T.17S. R.48&5W. WM.

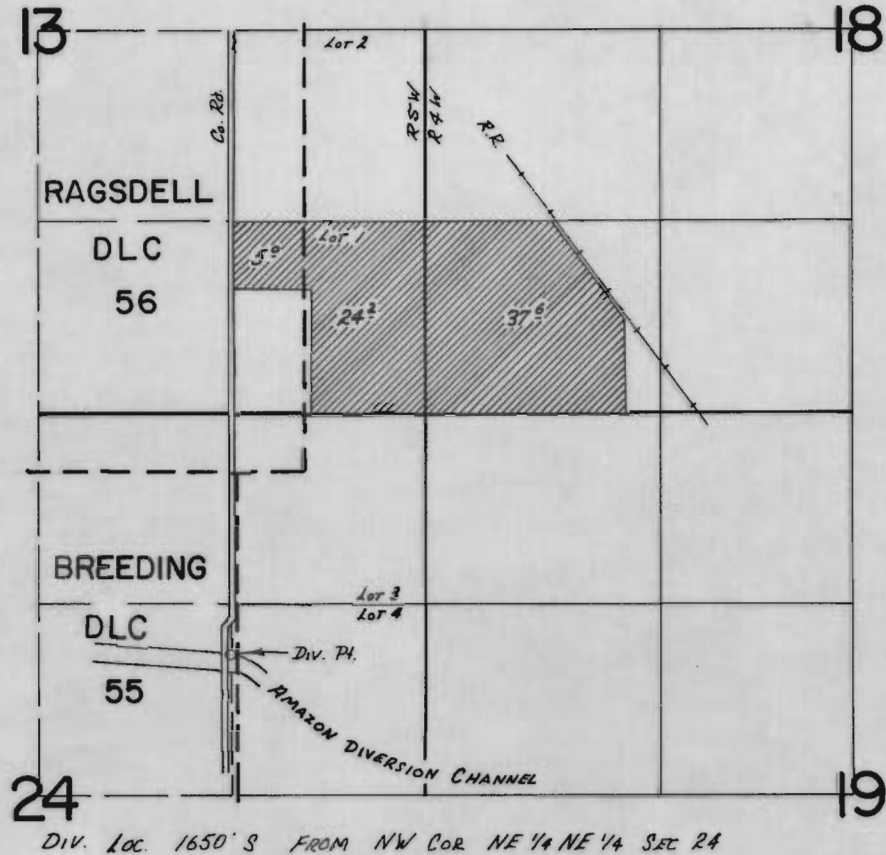

Div. Loc. 1650' S FROM NW COR NE 1/4 NE 1/4 SEC 24

**FINAL PROOF SURVEY**  
UNDER

Application No. 48086 Permit No. 36112  
IN NAME OF

MRS. JULIAN SUSTELLO

Surveyed May 7 1974, by T. J. PAUL