


T.17S. R.11&12W. W. M.

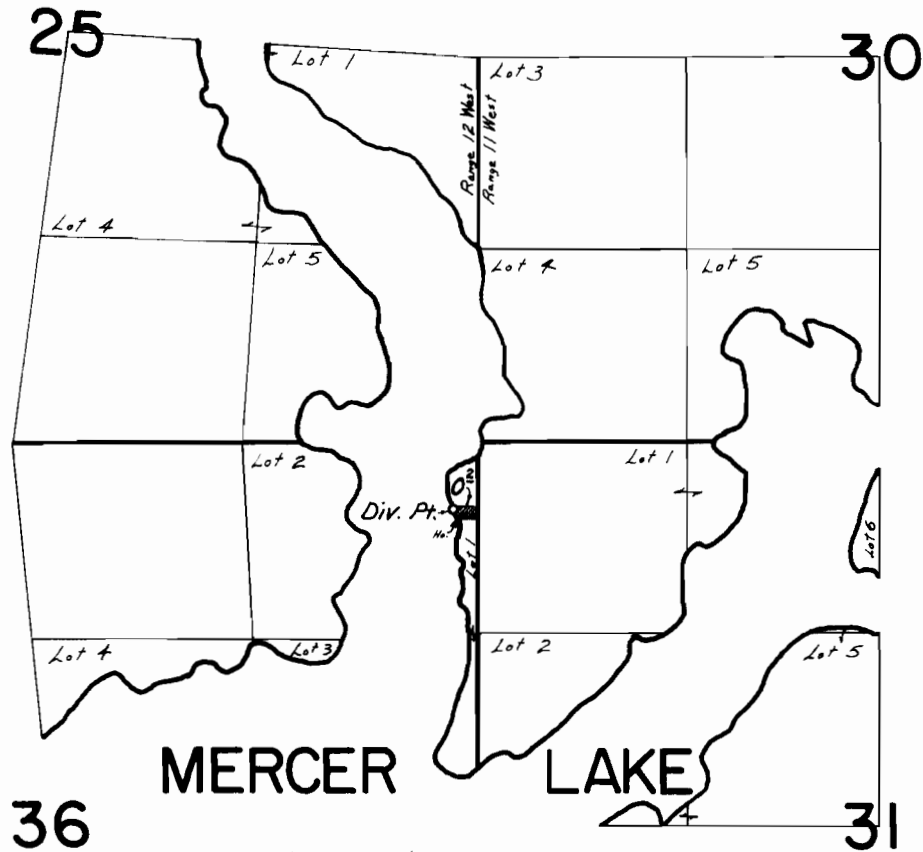

Div. Pt. Loc: 360' S. & 160' W. from the NE. meander cor. gov't lot 1,
Sec. 36, Twp. 17S. Rng. 12W. W.M.

FINAL PROOF SURVEY
UNDER

Application No. 49174... Permit No. 36155...
IN NAME OF

W. J. MCGILLVREY JR.

Surveyed JULY 10, 1974, by L. E. GOULD