


T.19S.R.1W.W.M.

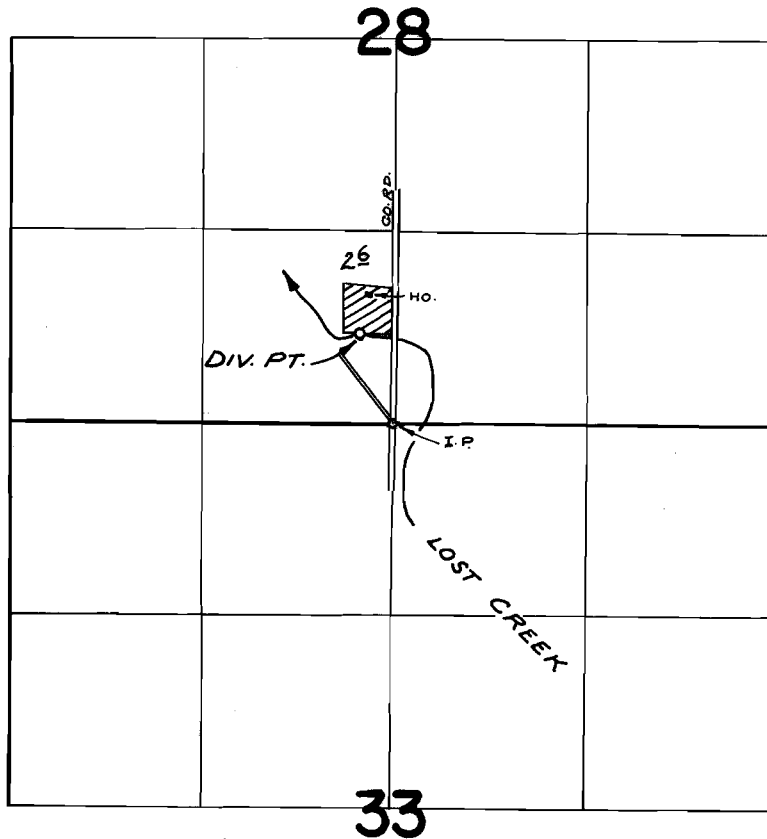

DIV. PT. LOC: 630' N. & 230' W. FROM S $\frac{1}{4}$ COR. SEC. 28

FINAL PROOF SURVEY
UNDER

Application No. 48192 Permit No. 36199
IN NAME OF

JESS C. & CLARA M. BYERS

Surveyed MAY 8, 1974, by R. MUCKEN.