


T.20S. R.4W. W.M.

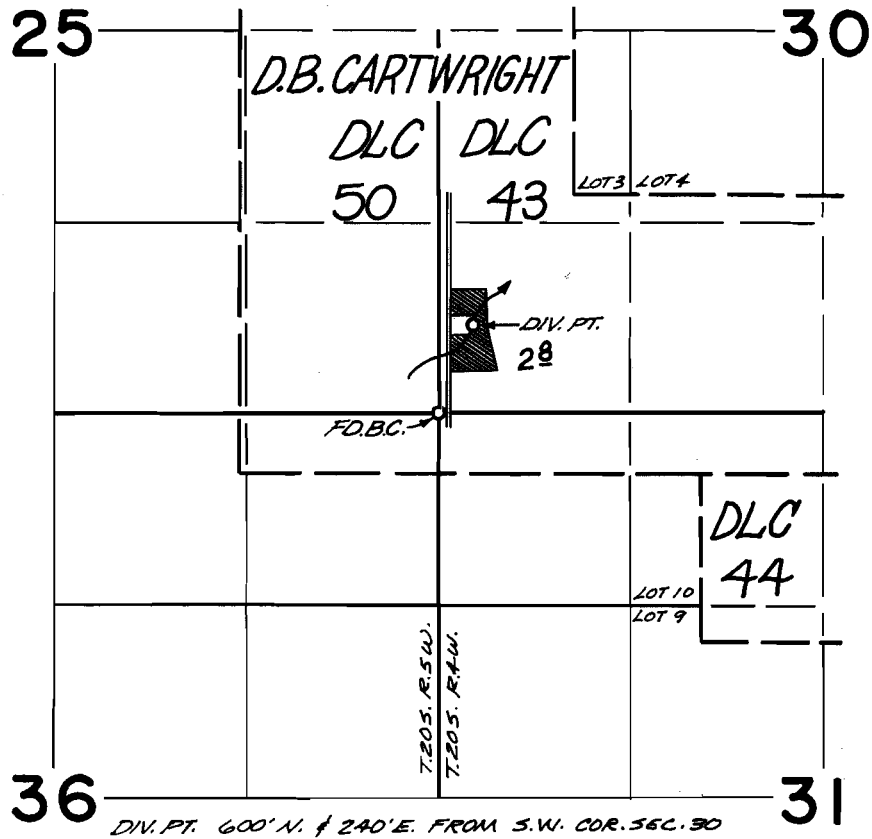

FINAL PROOF SURVEY
UNDER

Application No. 49981 Permit No. 36415
IN NAME OF

DAVID M. & LORETTA M. TIPPETT

Surveyed AUG. 14. 1974, by D. NOREY