


T.16S. R.2E. W.M.

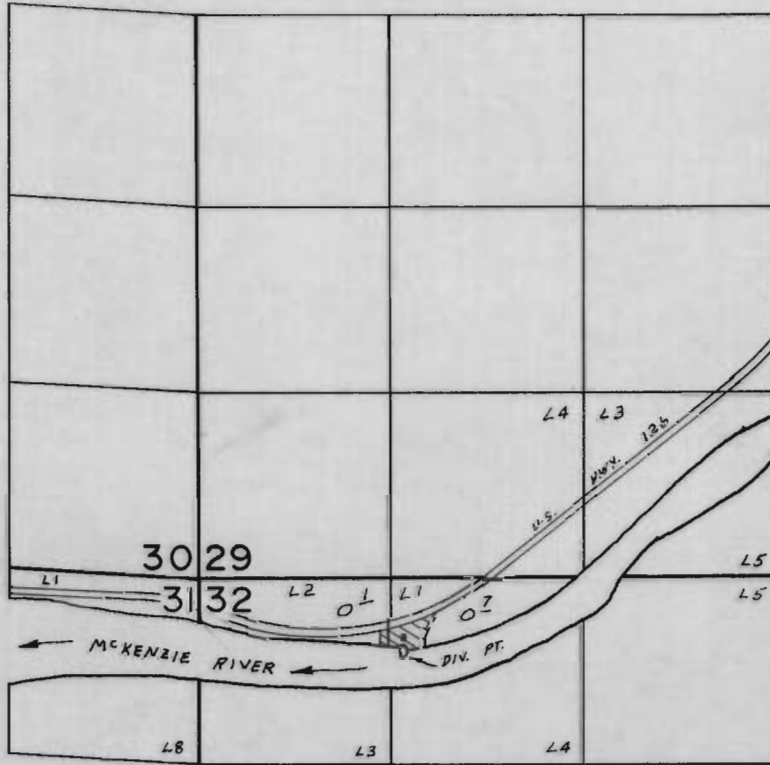

DIV. PT. LOC. 500' S & 1440' E OF NW COR. SEC. 32

FINAL PROOF SURVEY
UNDER

Application No. 49379 Permit No. 37012
IN NAME OF

WILLIAM A. & EVELYN B. CONNORS

Surveyed AUG 22 1974, by LH NUNN