


T.21S. R.3W. W.M.

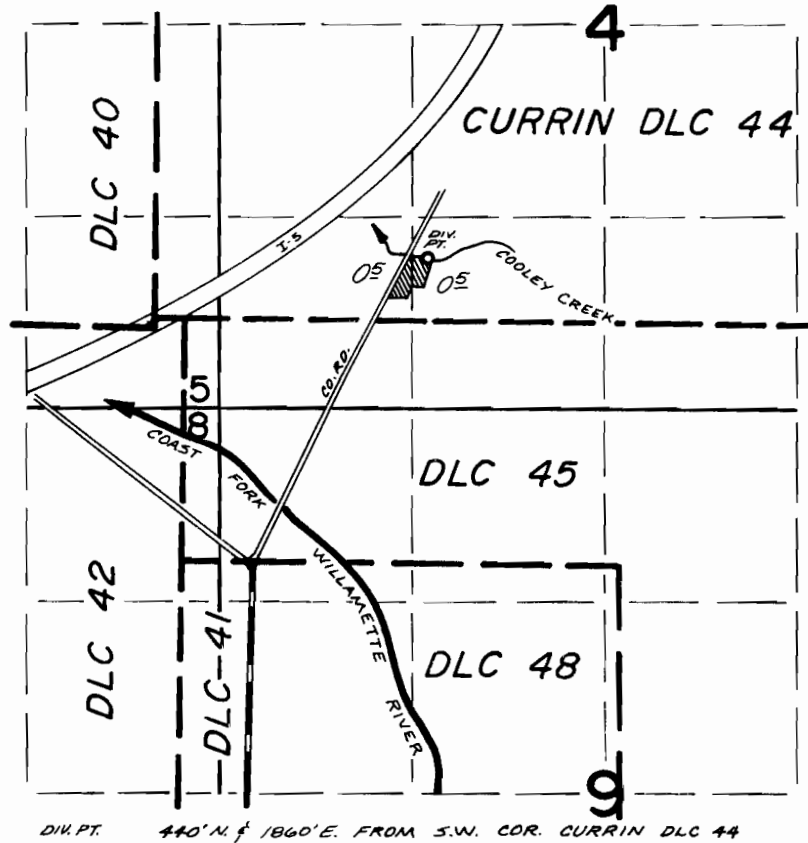

FINAL PROOF SURVEY
UNDER

Application No. 51272 Permit No. 37328
IN NAME OF

HENRY A. ERNST

Surveyed AUG. 13 1974, by D. NORBY