


T.11S., R.3W., W.M.

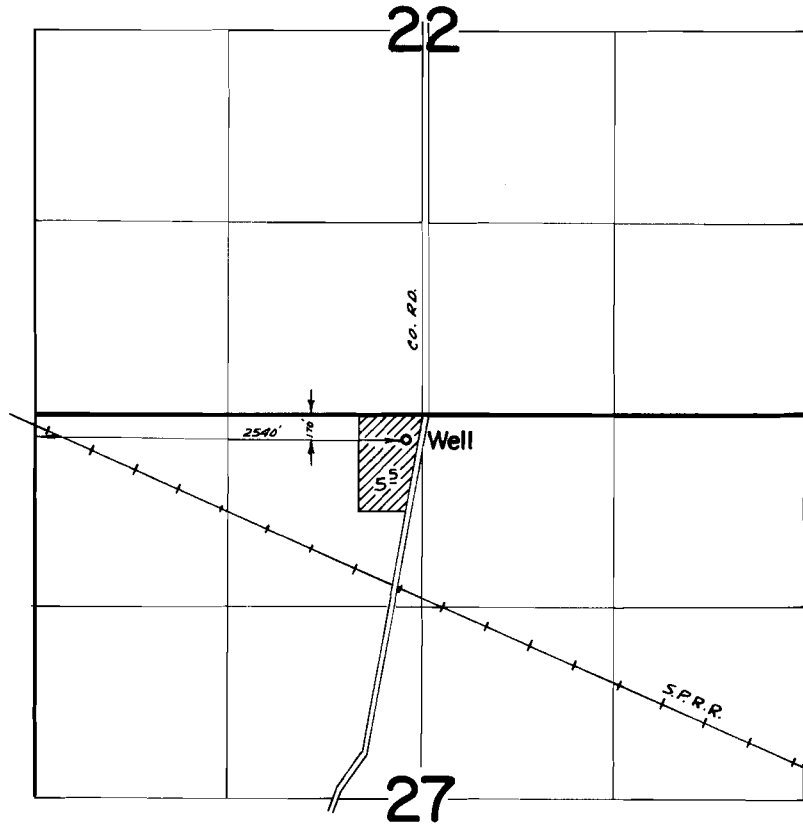

FINAL PROOF SURVEY
UNDER

Application No. G-4482 Permit No. G-4223
IN NAME OF

DANIEL D. AND EDNA WIDMER

Surveyed April 1 1974, by D.M. Norby