


T.9&10S., R.3W., W.M.

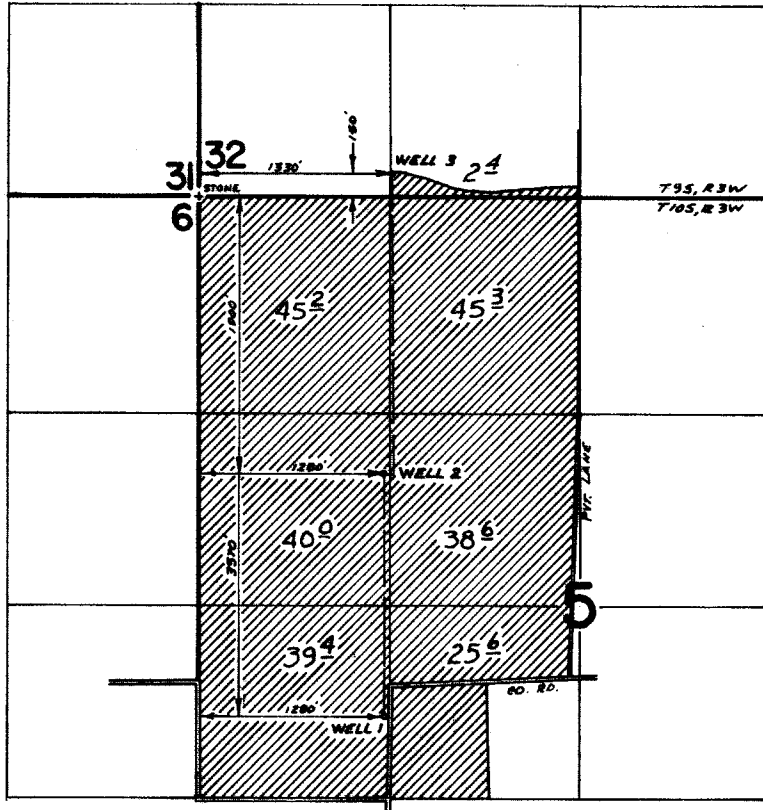

FINAL PROOF SURVEY UNDER

Application No. G-4734 Permit No. G-4454
IN NAME OF

PERRY A. DAVIS

Surveyed Oct. 18 1974, by D. Norby