


T.11S., R.48&5W., W.M.

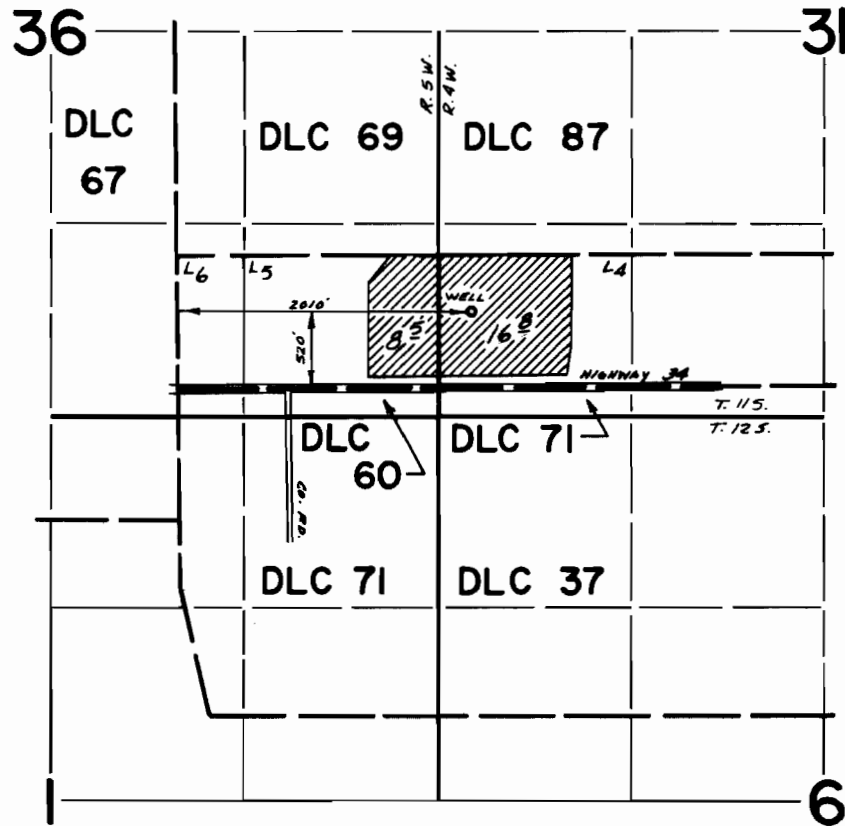

**FINAL PROOF SURVEY**  
UNDER

Application No. G-4958 Permit No. G-4679  
IN NAME OF

MAE Z. SMITH

Surveyed May 2 1974, by D.M. Norby