



4N., R.27E., W.1

RECEIVED

HANSELL BROTHERS INC. FINAL PROOF
AMENDED DECEMBER 11, 1996 and 2-4-97

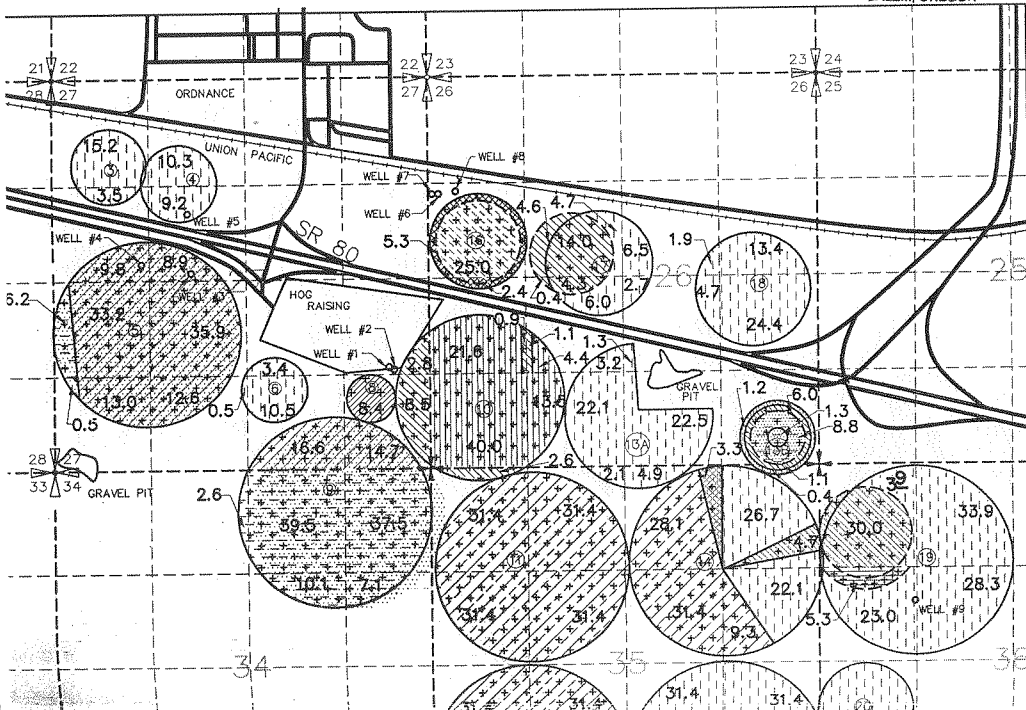



 
 


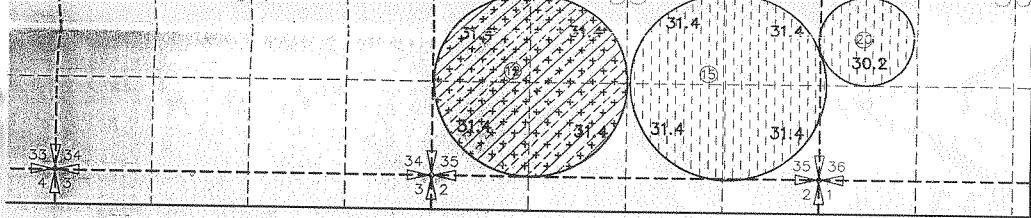



 
DEC 18 1996
WATER RESOURCES DEPT.
SALEM, OREGON




 

ELL 1 LOCATED 1420'N & 490'W FROM SE COR. SEC.27 BEING WITHIN NE $\frac{1}{4}$ SE $\frac{1}{4}$
 ELL 2 LOCATED 1390'N & 430'W FROM SE COR. SEC.27 BEING WITHIN NE $\frac{1}{4}$ SE $\frac{1}{4}$
 ELL 3 LOCATED 2740'N & 1890'E FROM SW COR. SEC.27 BEING WITHIN SE $\frac{1}{4}$ NW $\frac{1}{4}$
 ELL 4 LOCATED 230'N & 1210'E FROM W $\frac{1}{4}$ COR. SEC.27 BEING WITHIN SW $\frac{1}{4}$ NW $\frac{1}{4}$

WELL 5 LOCATED 960'N & 1850'E FROM W $\frac{1}{4}$ COR SEC.27 BEING WITHIN SE $\frac{1}{4}$ NW $\frac{1}{4}$
 WELL 6,7 LOCATED 1130'N & 60'E FROM W $\frac{1}{4}$ COR. SEC.26 BEING WITHIN SW $\frac{1}{4}$ NW $\frac{1}{4}$
 WELL 8 LOCATED 1160'N & 370'E FROM W $\frac{1}{4}$ COR. SEC.26 BEING WITHIN SW $\frac{1}{4}$ NW $\frac{1}{4}$
 WELL 9 LOCATED 1884'S & 1315'E FROM NW COR. SEC.36 BEING WITHIN SW $\frac{1}{4}$ NW $\frac{1}{4}$

 	T-4152		PERMIT NO. G-2694	①	CIRCLE NUMBER
	PERMIT NO. U-649		T-4928	31.4	IRRIGATED ACREAGE
	PERMIT NO. G-3822 SUPPLEMENTAL & T-4929		PERMIT NO. G-2335		
	G-3822 PRIMARY		T-4926		
	PERMIT NO. G-2672		PERMIT NO. G-1671		
	PERMIT NO. G-10505 SUPPLEMENTAL		T-4927		
	PERMIT NO. G-10505 PRIMARY				

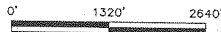

NOTE: THE PURPOSE OF THIS MAP IS TO IDENTIFY THE APPROXIMATE LOCATION OF THE WATER RIGHT. IT IS NOT INTENDED TO PROVIDE INFORMATION RELATIVE TO THE LOCATION OF PROPERTY OWNERSHIP BOUNDARY LINES.