


T.I.S., R.I.E., W.M.

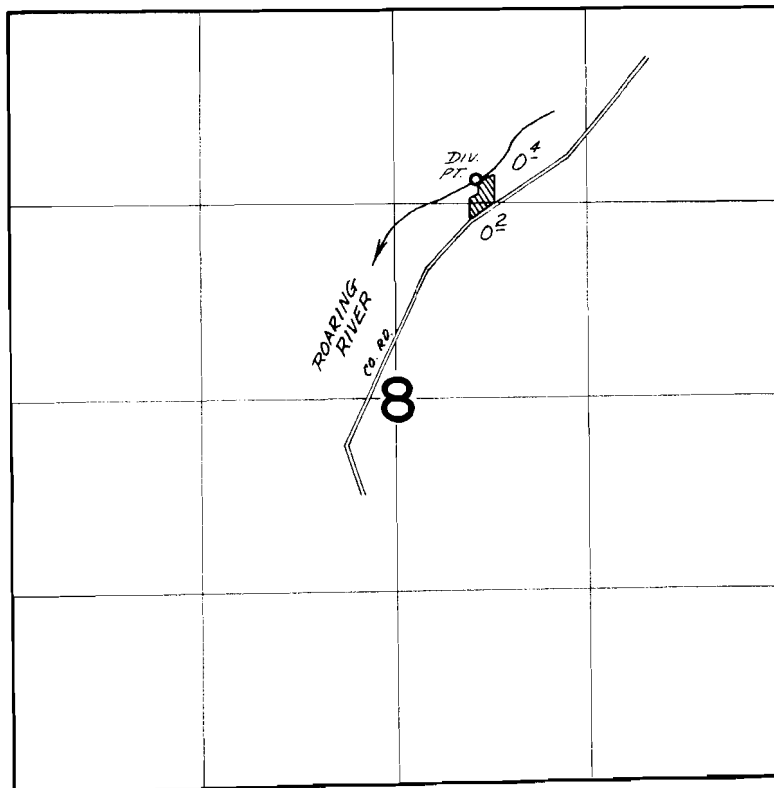

DIV. PT. LOCATED: 1500' N & 560' E FROM CENTER SEC. 8.

FINAL PROOF SURVEY
UNDER

Application No. 46361 Permit No. 34632
IN NAME OF

CLARENCE E. STONE

Surveyed April 3 1974, by S.P. Applegate