


T.13S. R.1E. W.M.

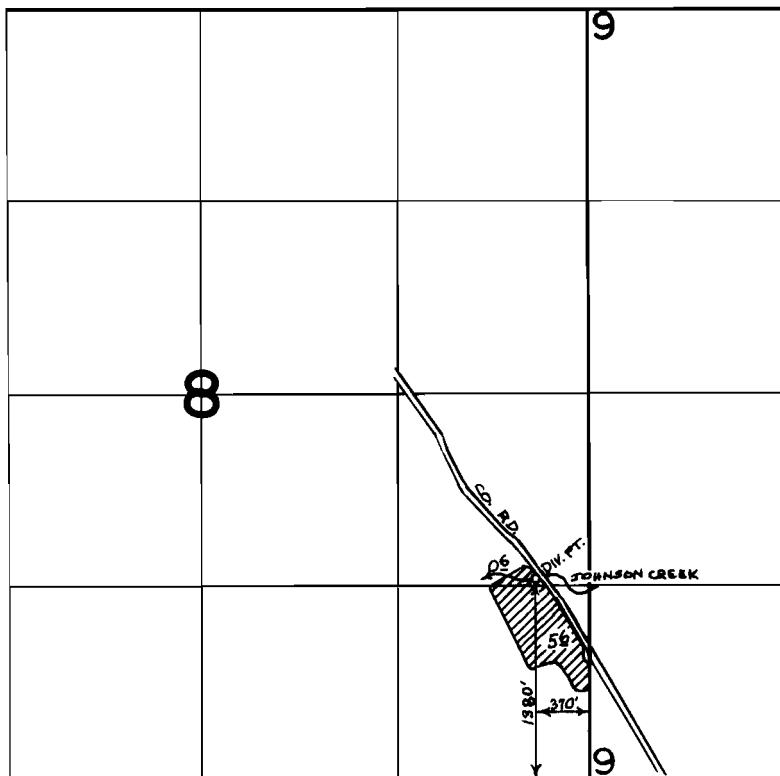

FINAL PROOF SURVEY
UNDER

Application No. 46618 Permit No. 34835
IN NAME OF

JAMES A. & ALTHEA GILBERTSON

Surveyed AUG. 9 1974, by D. NORBY