



T. 12S. R. 2W. W.M.

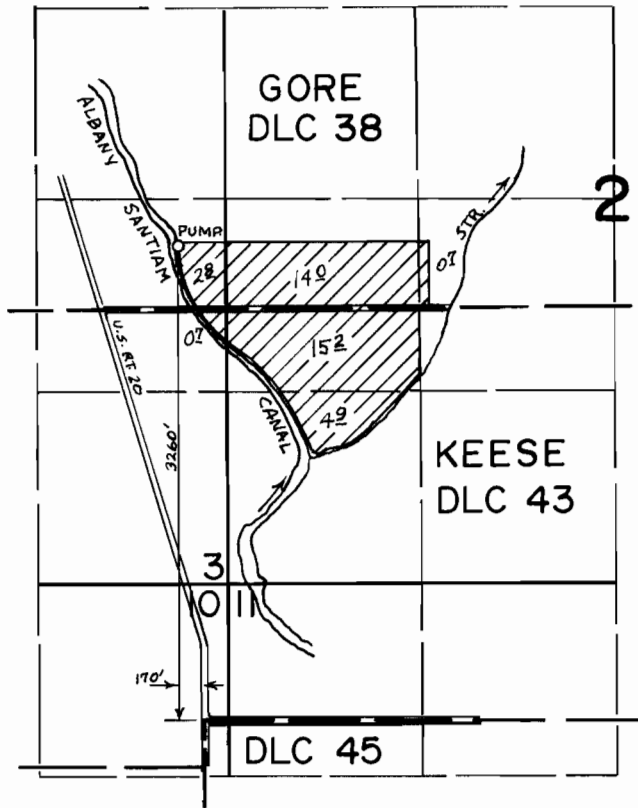

T. 12S. R. 1W. W.M.

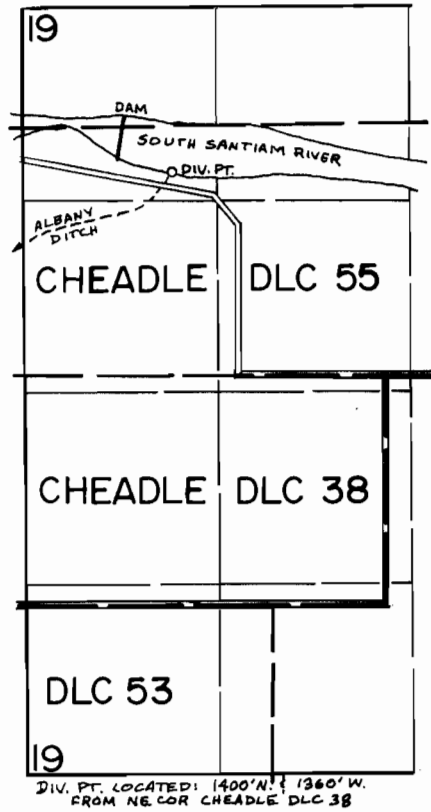

FINAL PROOF SURVEY
UNDER

Application No. 46906 Permit No. 34877
IN NAME OF

LEBANON IOOF CEMETERY & LEBANON MASONIC CEMETERY

Surveyed APR. 2, 1974 by S. APPLIGATE