


T. 13S. R. 1E. W.M.

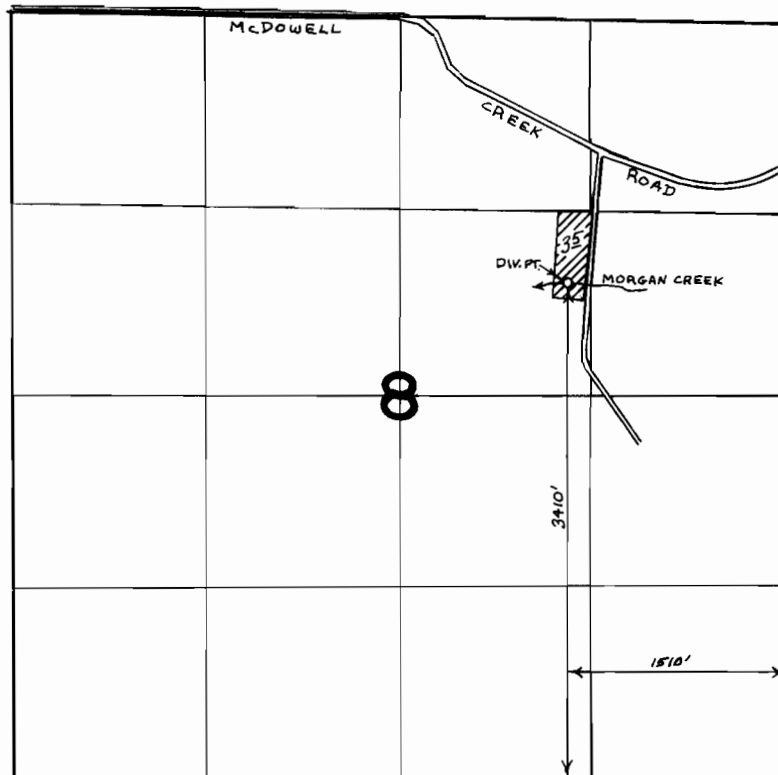

FINAL PROOF SURVEY
UNDER

Application No. 49686 Permit No. 37198
IN NAME OF

EARL J. & SHANNON J. MILLER

Surveyed AUG. 9 1974, by D. NORBY