T.5&6S.R.3W. W.M.

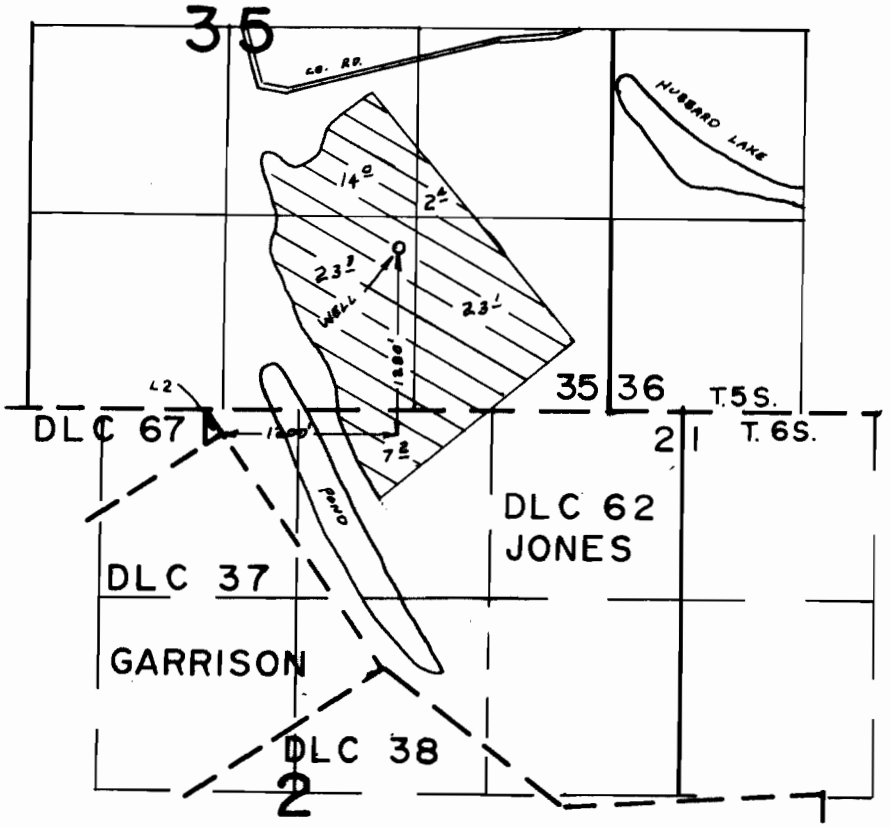

FINAL PROOF SURVEY
UNDER

Application No. G-4890 Permit No. G-4611
IN NAME OF

JOE AND RUTH RYAN

Surveyed SEP 4 1974, by L.H. NUNN

DFN-30-48 LHN