


T.5&6S. R.2W. W.M.

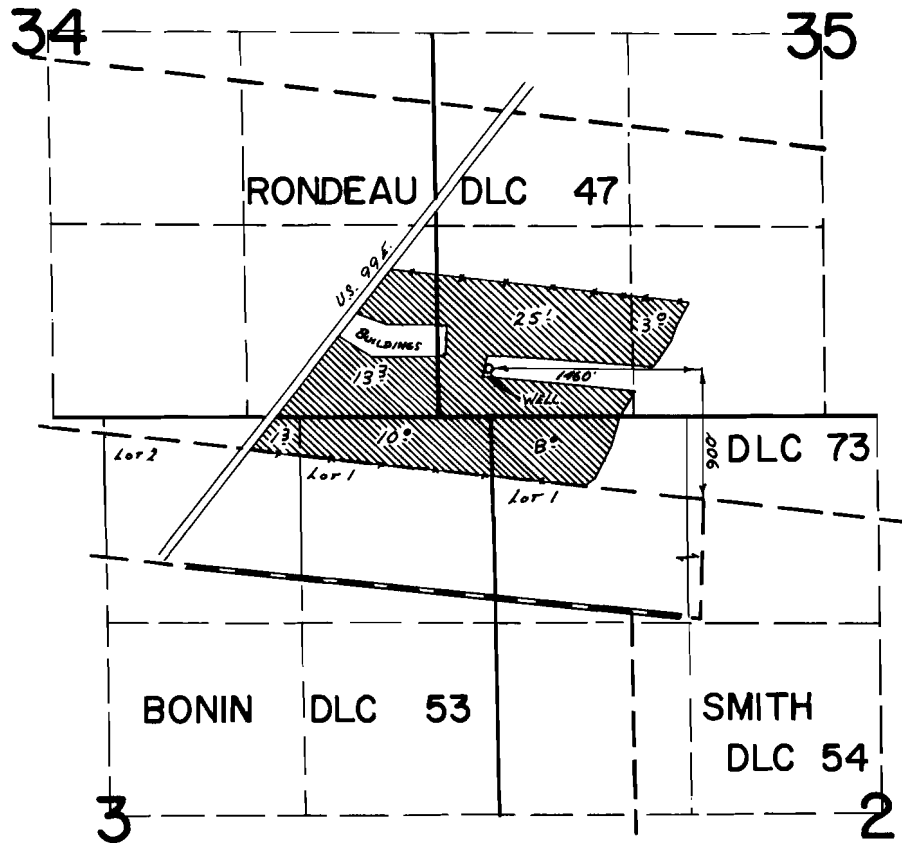

FINAL PROOF SURVEY
UNDER

Application No. G-5127... Permit No. G-4864.
IN NAME OF

..... N. H. GILLES

Surveyed April..11.. 1974, by T. J. PAUL.....