


T.5S. R.1W. W.M.

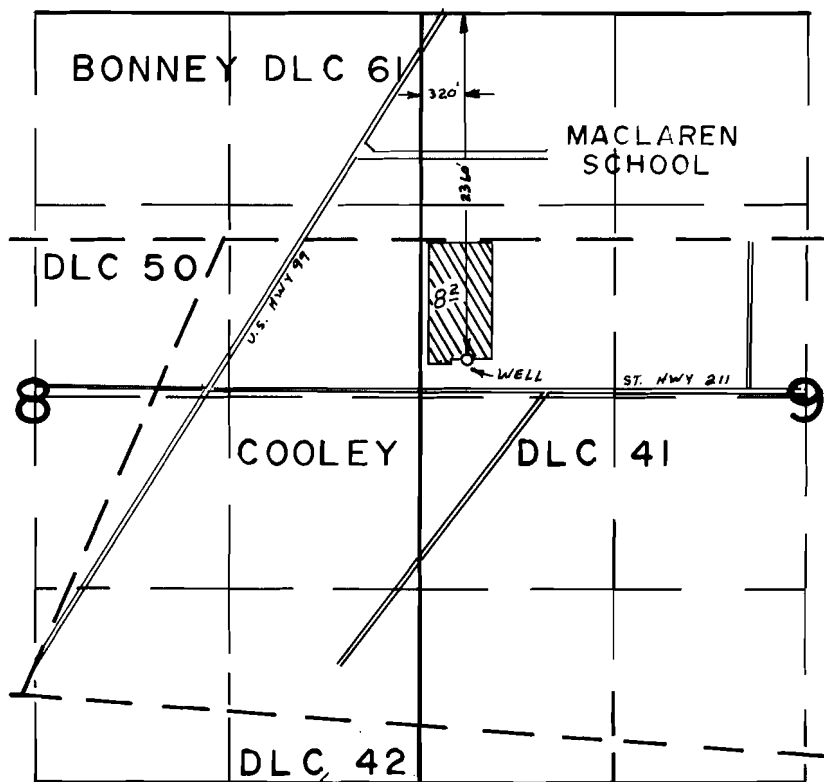

FINAL PROOF SURVEY UNDER

Application No. G-5134 Permit No. G-4869
IN NAME OF

FOREST E. BEESON

Surveyed MAY 24 1974, by LH NUNN