


T.7S. R.1E. W.M.

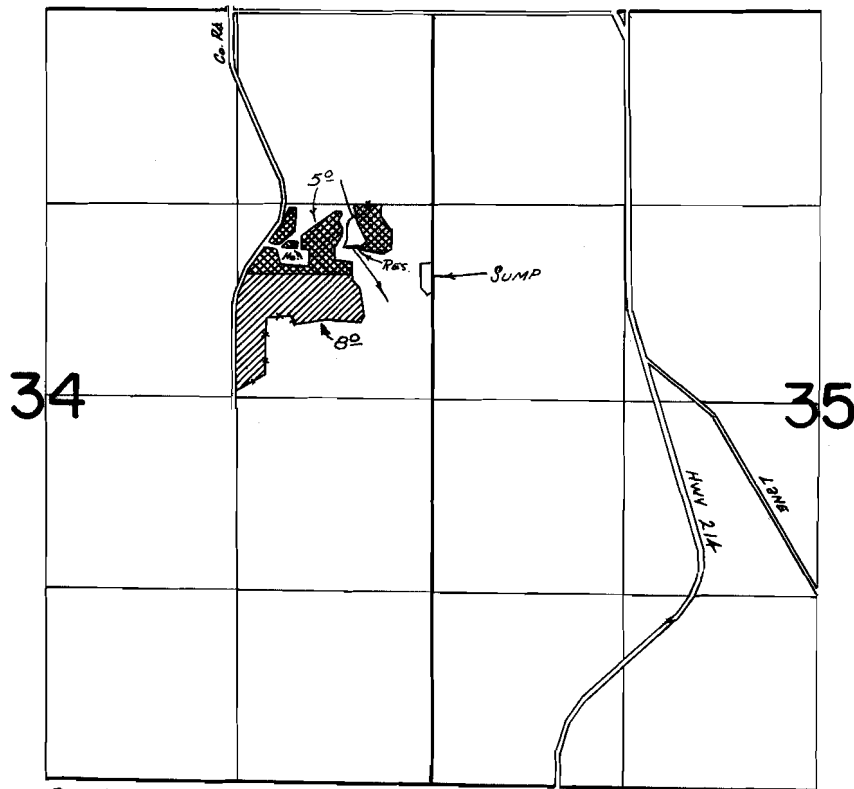

Res. Loc. 1840' S & 550' W. Sump Loc 1840' S & 30' W BOTH
FROM NE COR. SECTION 34.

FINAL PROOF SURVEY
UNDER

G-5566 G-4910
R-48414 R-5657
Application No. 48415 Permit No. 35268
IN NAME OF



JAMES T. & KATHLEEN A LEDBETTER

Surveyed Oct. 4 1974, by T. J. PAUL