


T. 5S. R. 1W. W.M.

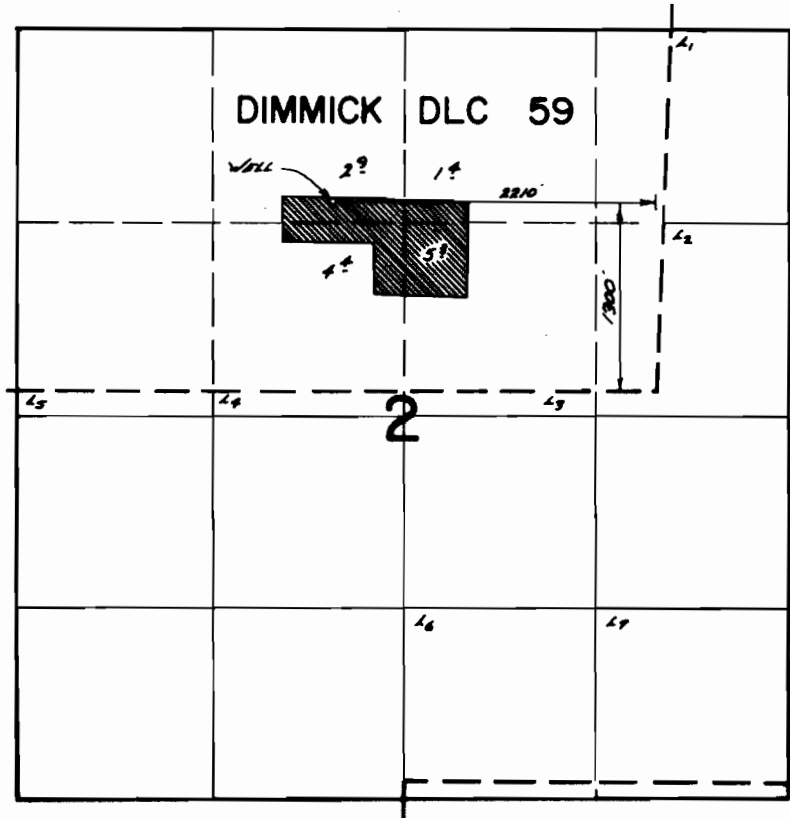

FINAL PROOF SURVEY UNDER

Application No. G-6032. Permit No. G-5168...
IN NAME OF

.....CARL E. WALKER.....

Surveyed April 11, 1974, by T. J. PAUL.....