


T.6S.,R.2W.,W.M.

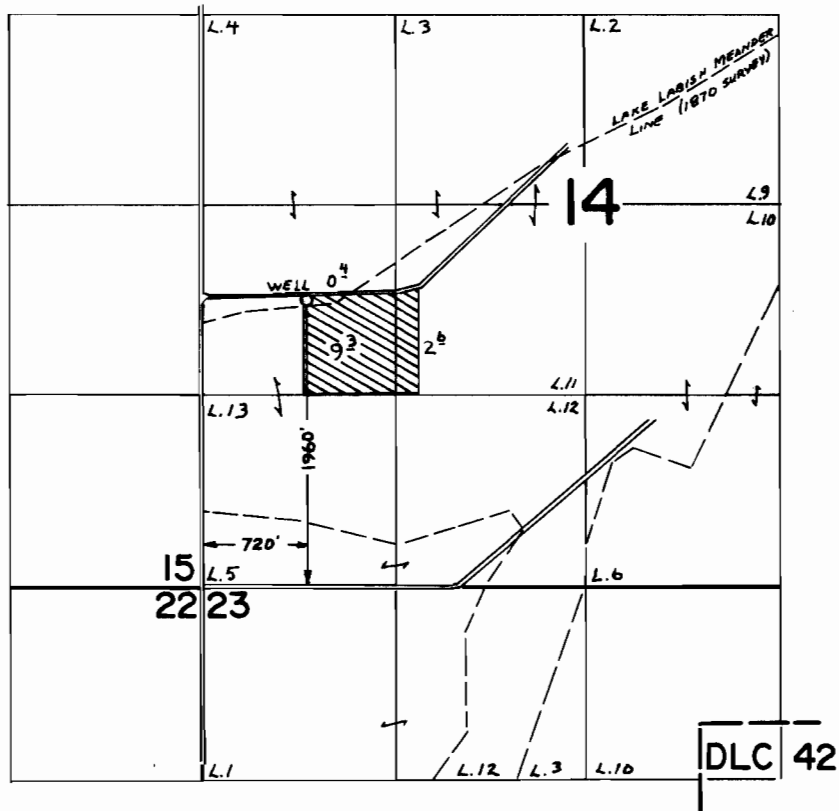

FINAL PROOF SURVEY
UNDER

Application No. G-6319 Permit No. G-5224
IN NAME OF

DENNIS MCCLAUGHRY

Surveyed SEPT. 3 1974, by L. TOLL