


T.3&4 S. R.2W. W.M.

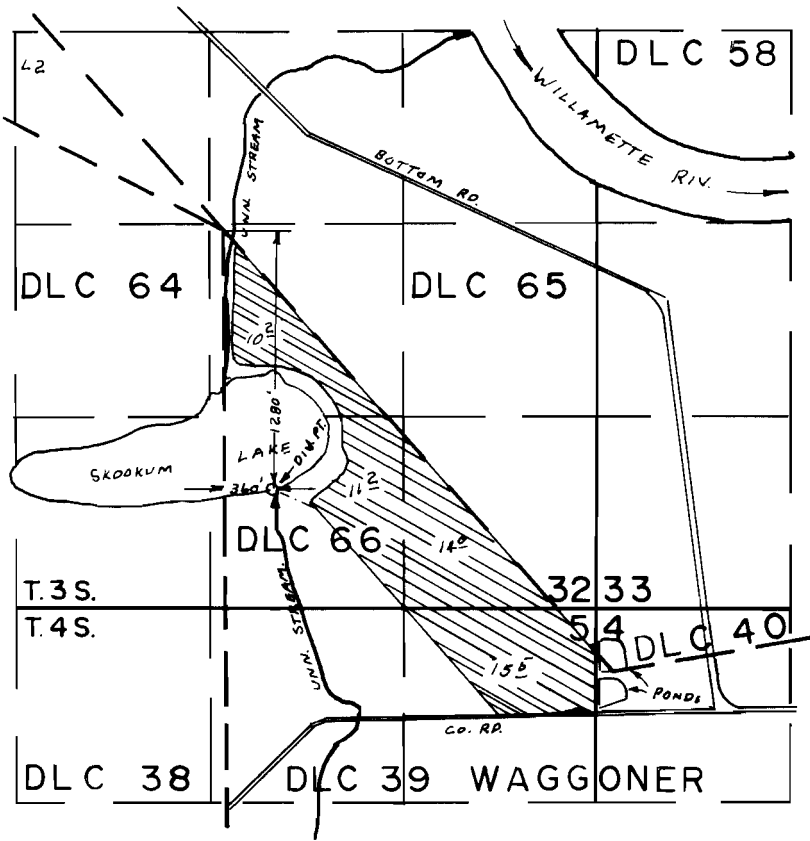

**FINAL PROOF SURVEY**  
UNDER

Application No. 46629 Permit No. 34843  
IN NAME OF

.....FRANK AND AFTON ISABELLA SEELY.....

Surveyed MAY 24 1974, by L.H. NUNN