


T.9S.,R.2E.,W.M.

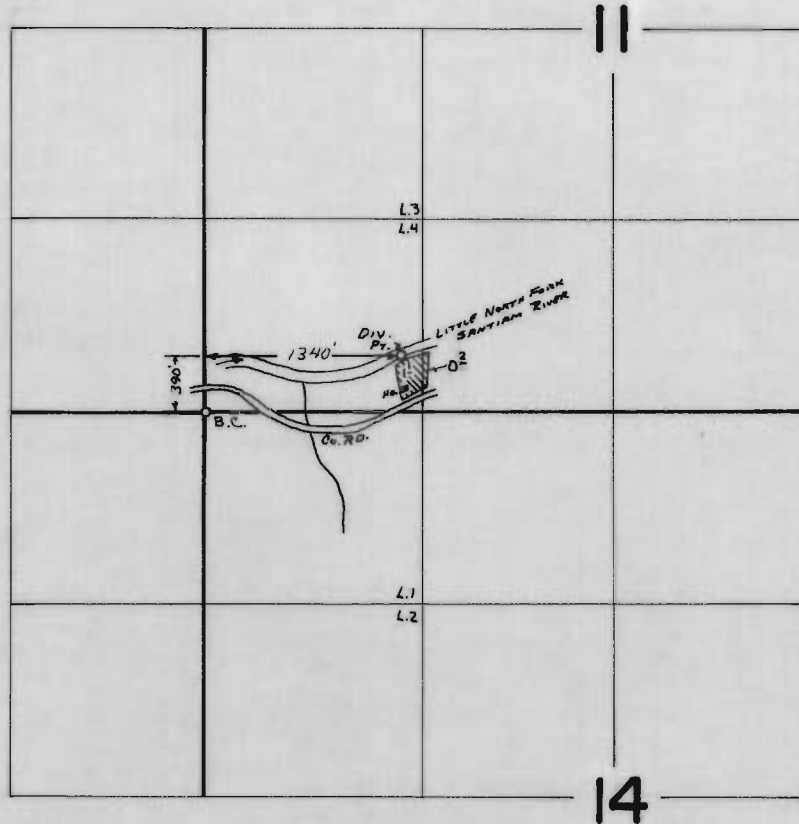

**FINAL PROOF SURVEY**  
UNDER

Application No. 48088 Permit No. 35262  
IN NAME OF  
TOM RICE

Surveyed Aug. 16 1974, by L. TOLL