


T. 4 S., R. 9&10 W., W.M.

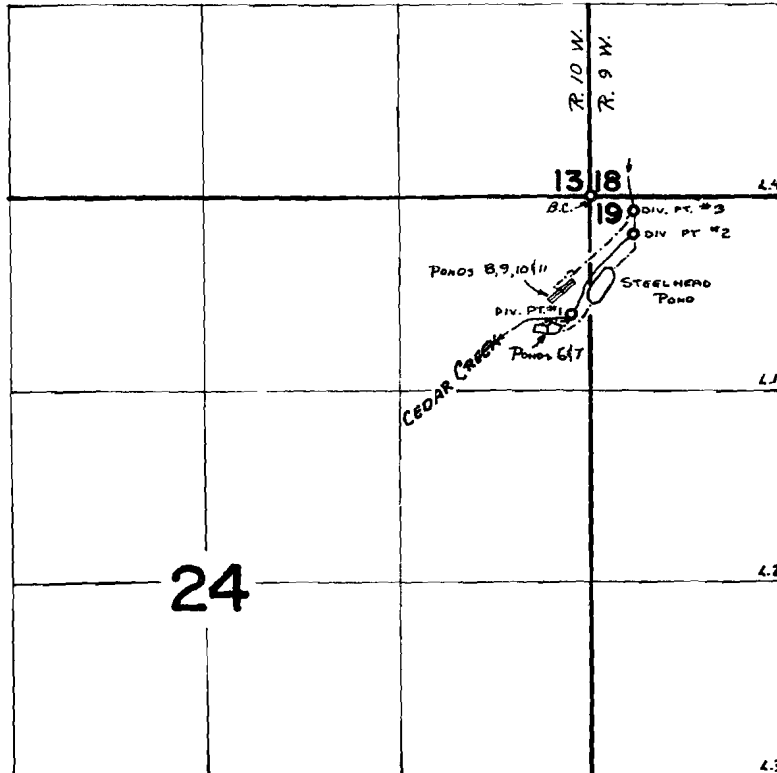

Loc: Div. Pt. #1 - 800' S AND 130' W FROM NE COR. SEC. 24
 Div. Pt. #2 - 250' S AND 300' E FROM NW COR. SEC. 19
 Div. Pt. #3 - 100' S AND 300' E FROM NW COR. SEC. 19

FINAL PROOF SURVEY

UNDER
 Transfer No. 2450 & 2451

45919
 R-45949
 R-47573
 47574
 R-47575

34307
 R-5464
 R-5731
 35619
 R-5732

Application No. 47576 Permit No. 35620

IN NAME OF

OREGON STATE GAME COMMISSION

Surveyed JUNE 25 1974, by L. TOLL