


T. 4 S., R. 9&10 W., W.M.

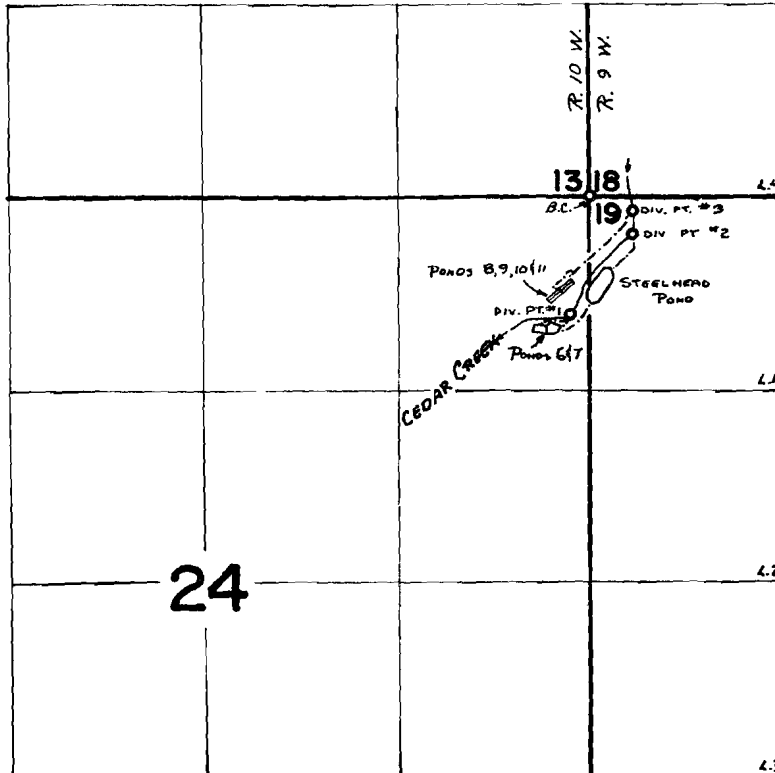

Loc: Div. Pt. #1 - 800' S AND 130' W FROM NE COR. SEC. 24
 Div. Pt. #2 - 250' S AND 300' E FROM NW COR. SEC. 19
 Div. Pt. #3 - 100' S AND 300' E FROM NW COR. SEC. 19

FINAL PROOF SURVEY

UNDER
 Transfer No. 2450 B - 2451

| | |
|-----------------------|------------------|
| 45919 | 34307 |
| R-45949 | R-5464 |
| R-47573 | R-5731 |
| 47574 | 35619 |
| R-47575 | R-5732 |
| Application No. 47576 | Permit No. 35620 |

IN NAME OF

OREGON STATE GAME COMMISSION

Surveyed JUNE 25 1974, by L. TOLL