


T. 1 S., R. 8 W., W.M.

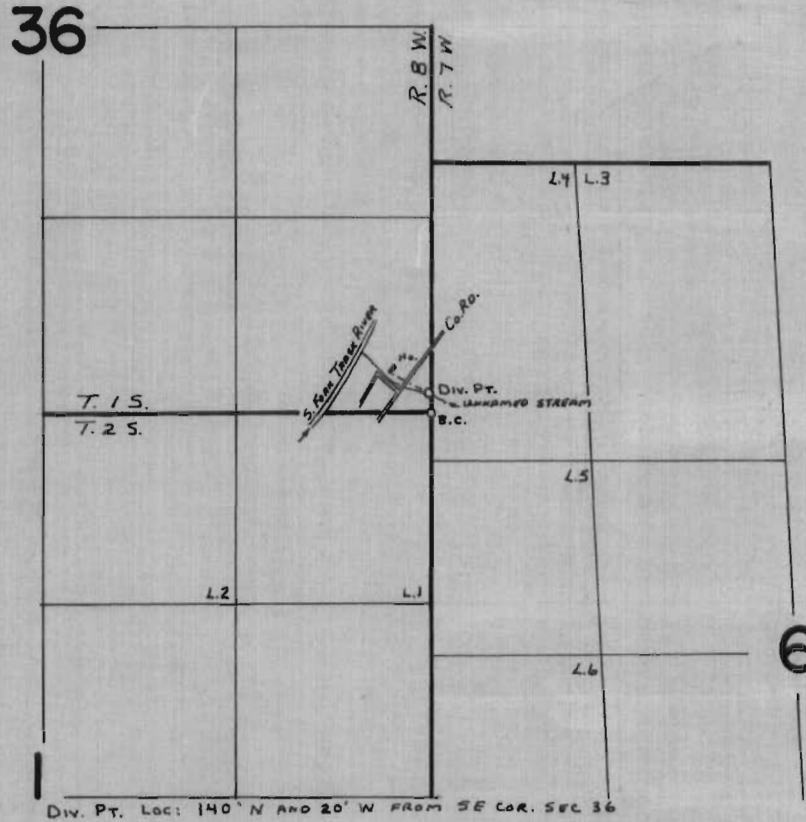

FINAL PROOF SURVEY UNDER

Application No. 47660 Permit No. 35662
IN NAME OF

LEONARD L. JOHNSON

Surveyed JUNE 24 1974, by L. TOLL