


T. 1 & 2 S., R. 8 W., W.M.

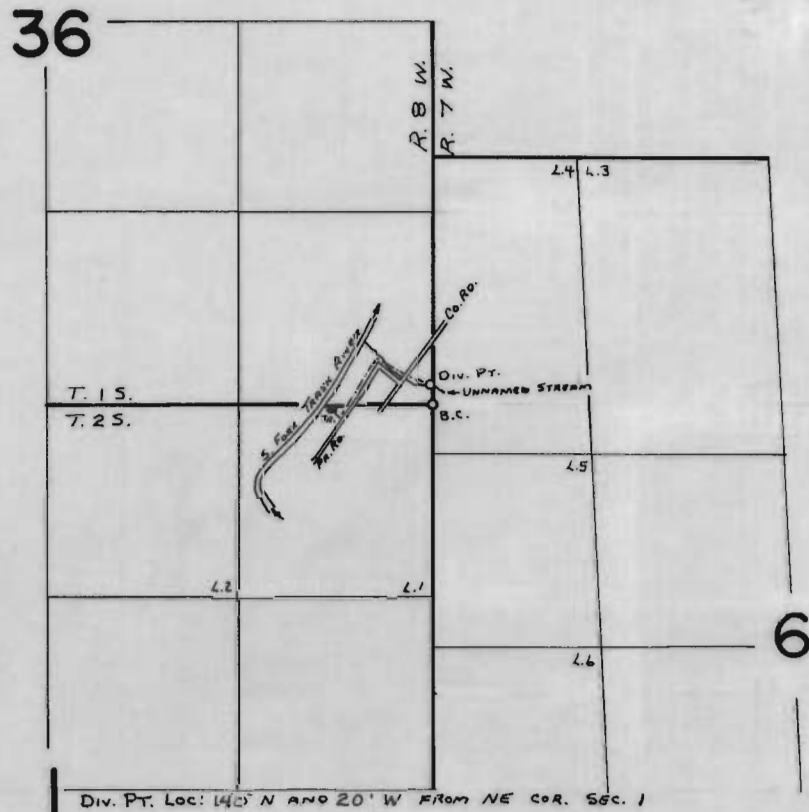

FINAL PROOF SURVEY
UNDER

Application No. 47795 Permit No. 35807...
IN NAME OF

JOHN A. & JOSEPHINE M. WEHINGER

Surveyed JUNE 25 1974, by L. TOLL.....