


T. 3 S., R. 10 W., W.M.

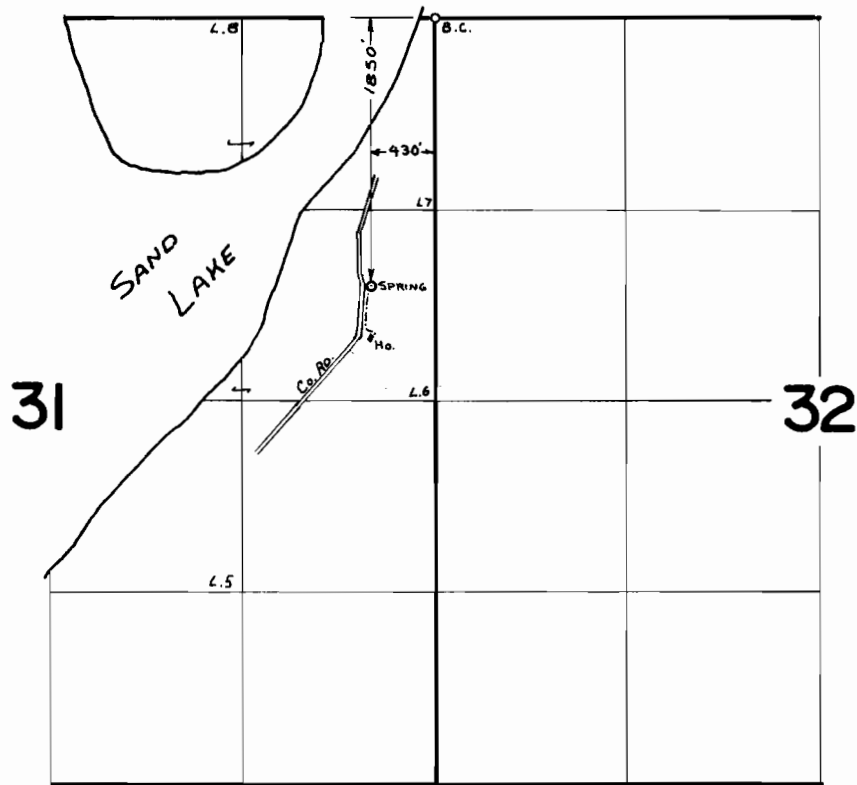

FINAL PROOF SURVEY
UNDER

Application No. **48744**... Permit No. **36070**...
IN NAME OF

WILLIAM.....FRANCIS.....HAZEN.....

Surveyed **Aug. 29** 1974, by **L. TOLL**.....