
T. 2 S.,R. 8 W.,W.M.

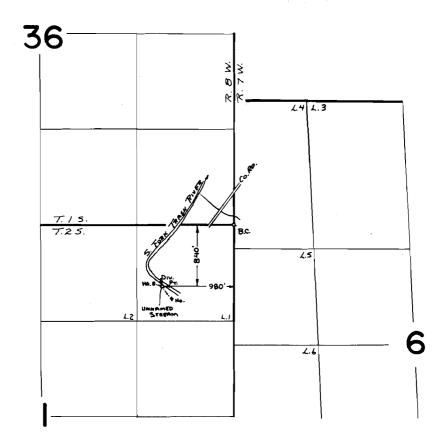

FINAL PROOF SURVEY

Application No. 48235 Permit No. 36223 IN NAME OF NORMAN P. & SALLY S. SORENSEN HOWARD L. & MARY E. EDWARDS

Surveyed June 26. 1974, by ...L. TOLL