


T.5S.,R.IIW.,W.M.

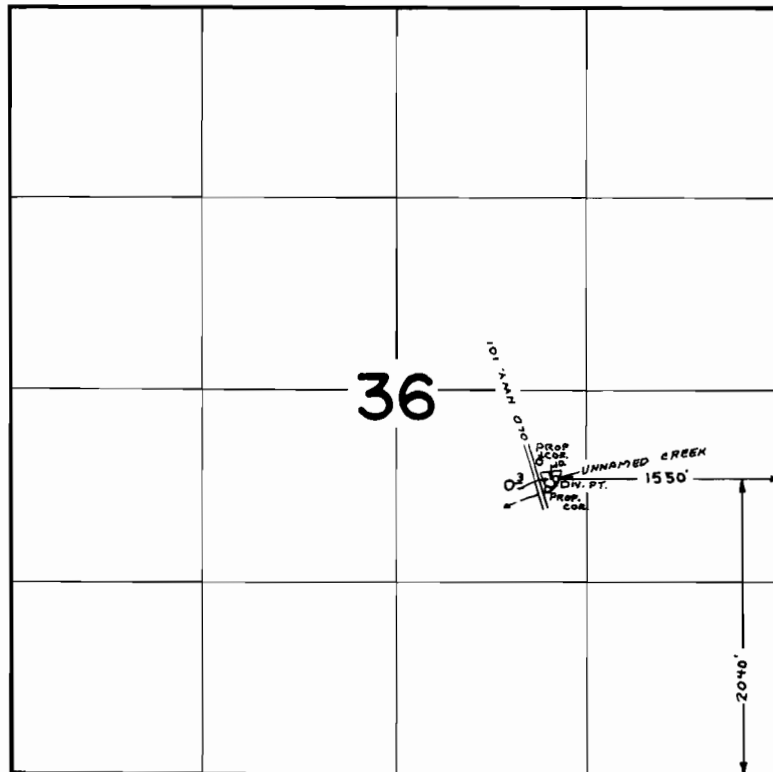

FINAL PROOF SURVEY
UNDER

Application No. 48920 Permit No. 36640
IN NAME OF

P. L. BEACH

Surveyed JUNE 28 1974, by L. TOLL